


RECEIVED

JAN 06 1986

WATER RESOURCES DEPT
SALEM, OREGON

Application No. G-11444

Permit No. G11148

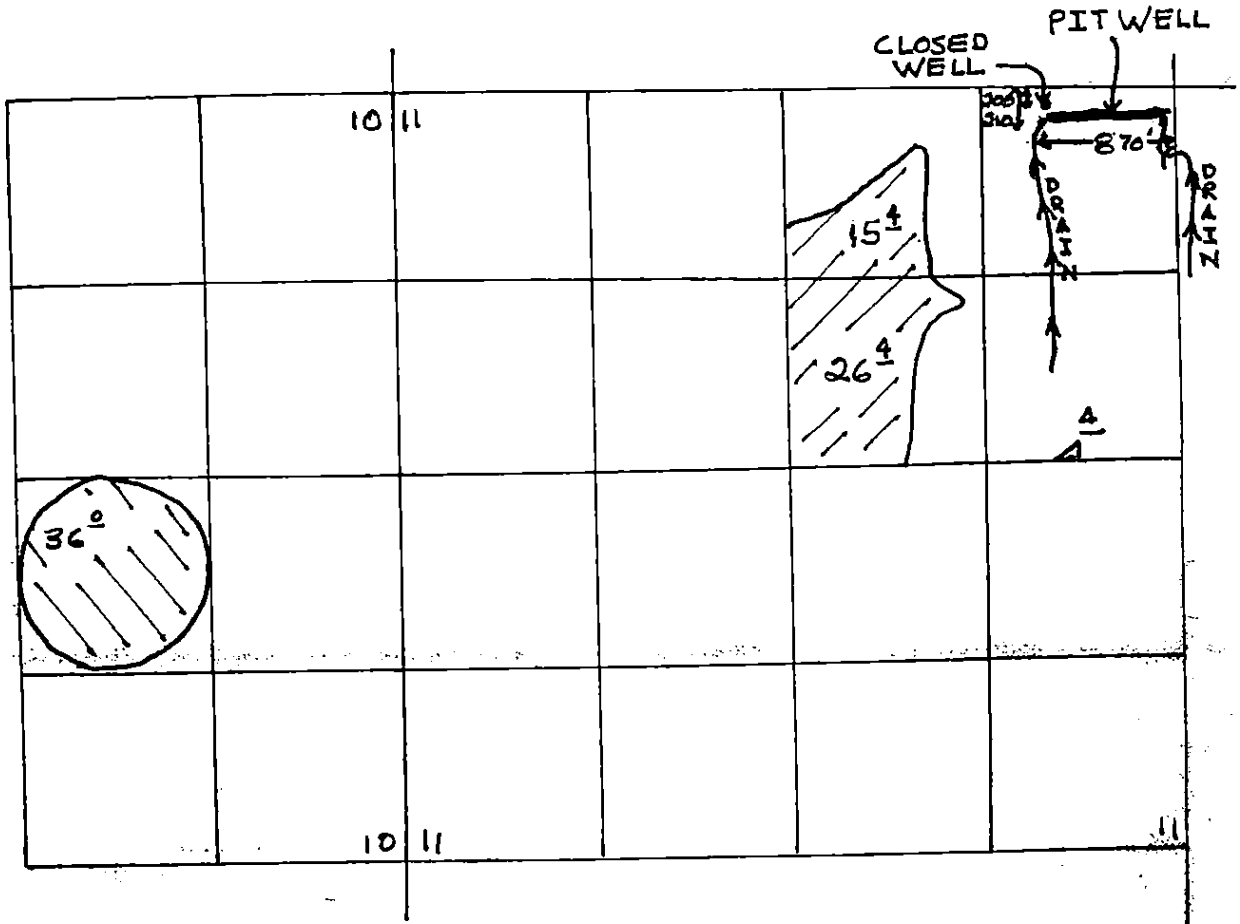

T. 3 N. R. 28 E.

Primary /// from closed well & pit well
under Application G-11444

REVISED MAP

~~Primary~~
~~Supplemental~~ ///

GROUND WATER

From PIT WELL & closed well
under right described by
Certificate 64441

RECEIVED
 JAN 06 1986
 WATER RESOURCES DEPT
 SALEM, OREGON