

906

CLAIM OF BENEFICIAL USE MAP T12S, R1W W.M. SEC 14 & 23

SCALE" 1" = 1320'

APPLICATION NO: S-80940



PERMIT NO: S-53440

APPLICANT: STEPHAN A. GILBERT
41374 UPPER BERLIN DR.
LEBANON, OR 97355
541-451-2423

RECEIVED

MAY 14 2015

WATER RESOURCES DEPT
SALEM, OREGON

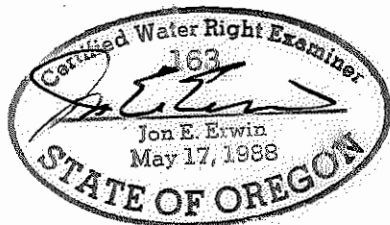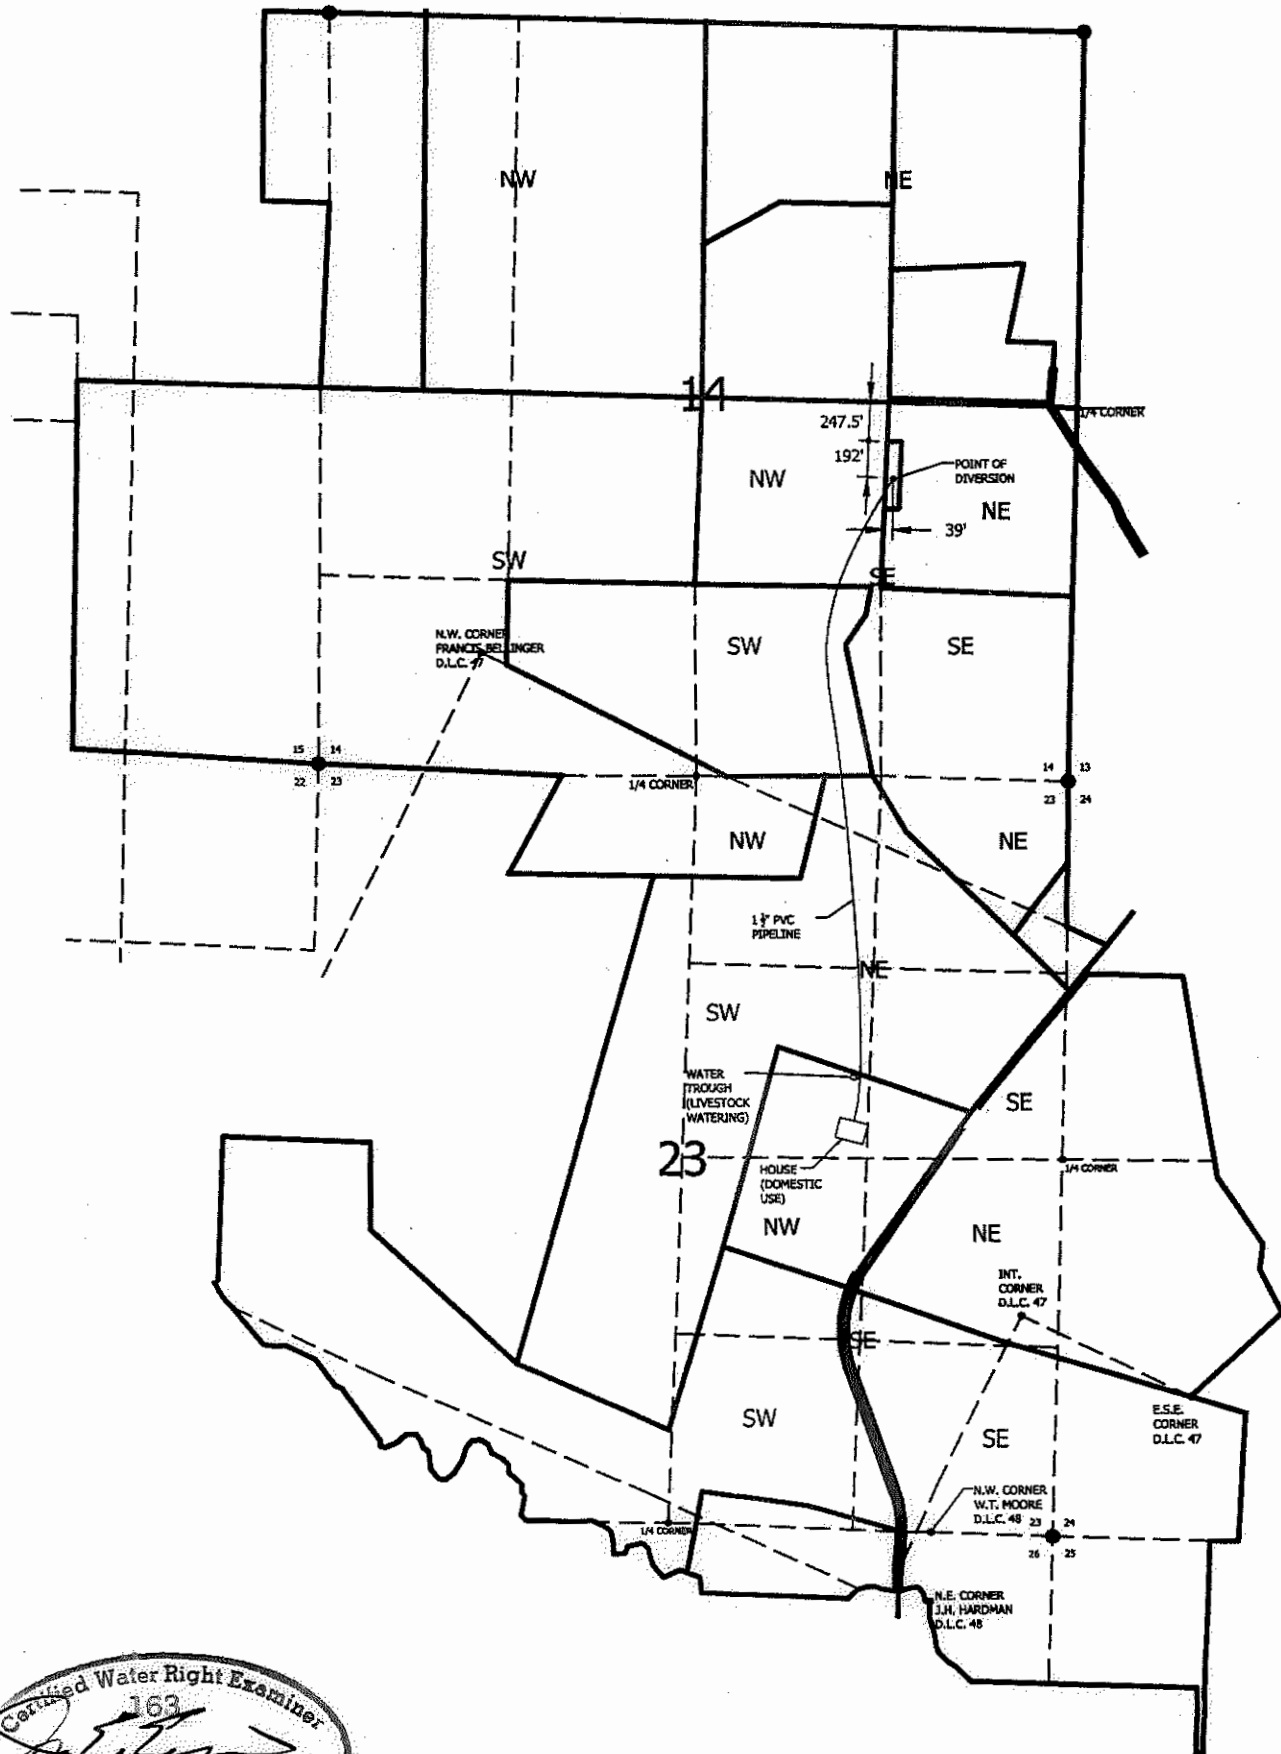

EXP 12-31-2015

NOTE:

THIS MAP IS FOR THE PURPOSE OF IDENTIFYING AREA OF USE
FOR A WATER RIGHT AND HAS NO INTENTION TO DIMENSION
OR LOCATE PROPERTY OWNERSHIP.

906 # 906