

Map of Claim of Beneficial Use

T-10909


T36S, R2W, Sec 18

Fred Owen Jr & Barbara Owen

RECEIVED


AUG 06 2018

OWRD

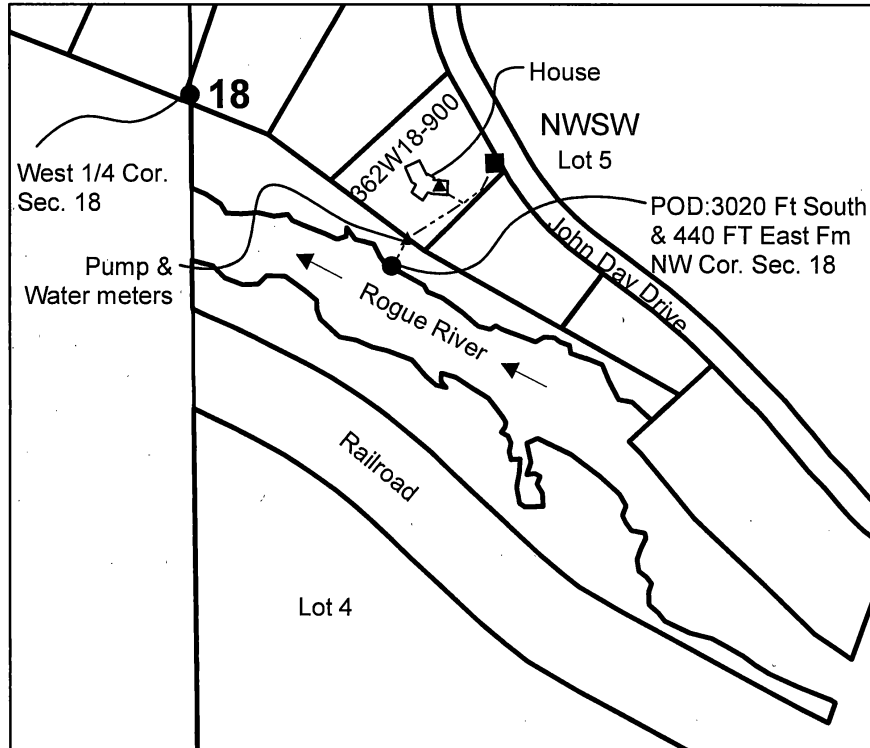

Legend

- ▲ Pump
- Pipeline
- Storage tanks
- Section line
- Quarter-Quarter line

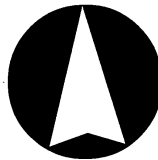

1 inch = 400 feet

Note: This map is not intended to provide legal dimensions or locations of property ownership lines.

