

T3S, R1E,
SECTION 21, WM

CLACKAMAS COUNTY, OREGON

37TH AVE

NWSW

NESW



0 400
Feet

1" = 400'

- POU NU
- Section
- Quarter Quarter
- Tax lot
- Well
- Meter

RECEIVED


MAR 02 2018

OWRD

SESW

WELL LOCATIONS:

- #2: 640' N, 835' E OF SW COR S21
- #3: 680' N, 440' E OF SW COR S21
- #4: 530' N, 440' E OF SW COR S21

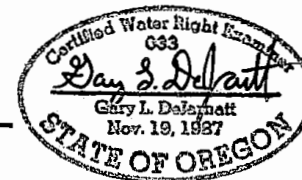

RENEWAL DATE 12/31/2017



CLAIM OF BENEFICIAL USE
Holewa / Beck / Lewis

TRANSFER T-10857

NOTE: THIS MAP IS NOT INTENDED TO
PROVIDE LEGAL DIMENSIONS OR LOCATIONS
OF PROPERTY OWNERSHIP LINES.

PROJECT #17050

AUGUST 29, 2017

WATER RIGHT SERVICES, LLC

PO BOX 1830, BEND, OR 97709

CCB# 197121 www.oregonwater.us

541-389-2837 JOHNSHORT@USA.COM