


SEC. 14, T.8S., R.38E., W.M.

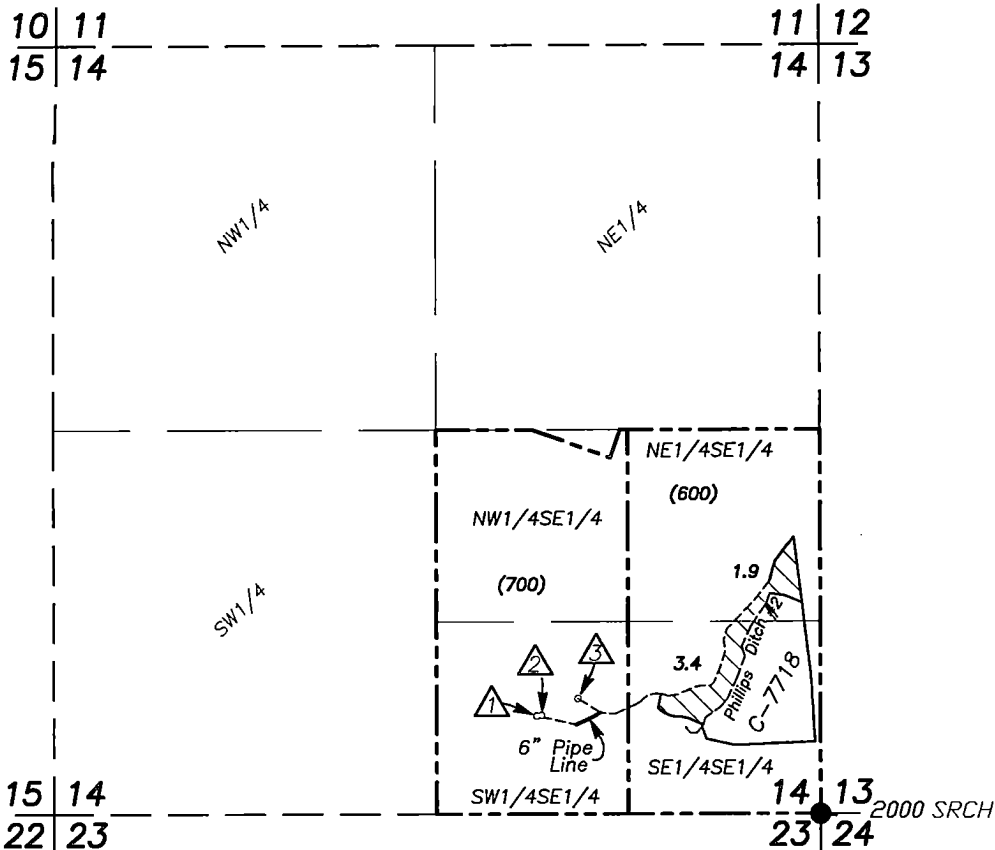

SCALE: 1" = 1320'

RECEIVED BY OWRD

AUG 21 2017

SALEM, OR

LEGEND

△ SPRING #1: 670 ft. North & 1950 ft. West of SE Cor. Section 14, T8S, R38E.

△ SPRING #2: 670 ft. North & 1940 ft. West of SE Cor. Section 14, T8S, R38E.

△ SPRING #3: 790 ft. North & 1670 ft. West of SE Cor. Section 14, T8S, R38E.

▨ Current Place of Use Permit S-47594

----- Ditch

----- Tax Lot Line

() Tax Lot No.

● Found 2" Iron Pipe at SE Cor. Sec. 14, T8S, R38E

FINAL PROOF SURVEY

Under

APPLICATION S-64940

PERMIT S-47594

In Name Of

AVERETT RANCH, LLC

13619 Hunt Mountain Lane
Baker City, OR 97814

Prepared By:

Michael C. Springer, PLS, CWRE
Benchmark Land Surveying

217 N. Canyon Blvd.

John Day, Oregon

(541) 575-1251

benchmarkls.com

Survey Conducted April 17, 2017



DISCLAIMER: THIS MAP IS NOT INTENDED TO PROVIDE LEGAL DIMENSIONS OR LOCATIONS OF PROPERTY BOUNDARY LINES.

RENEWS: 6/31/2018