


T.18S. R.8E. Section 29, W.M.

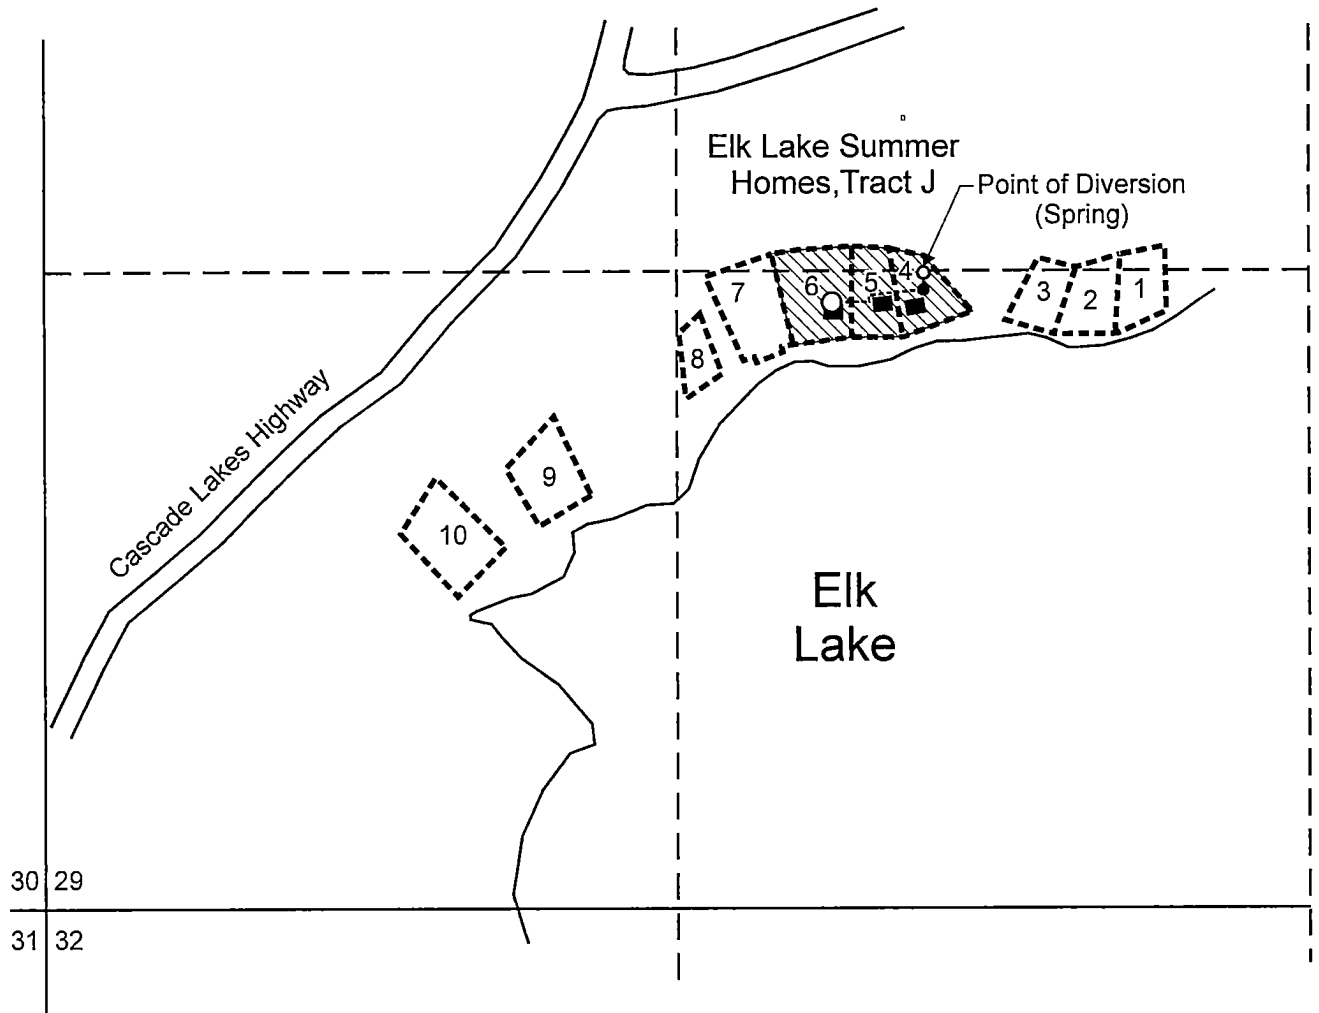

Point of diversion (spring) is located 1,320 feet north and 1,840 feet east from the SW corner, Section 29.

Area of use for Human Consumption.


Tax lot boundary

Cabin Location

Pump Location


Meter Location

Mainline

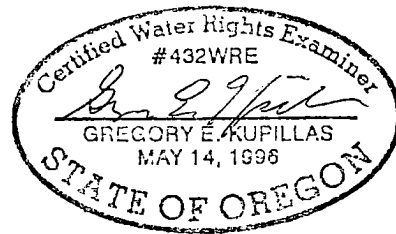


EXPIRATION DATE: 6/30/2015

Scale: 1" = 400'

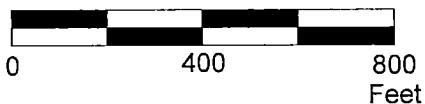

This map was prepared for the purpose of identifying the location of a water right only and is not intended to provide legal dimensions or location of property ownership lines.

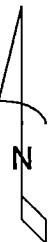

COBU Elk Lake Leet.cdr

Pacific Hydro-Geology Inc.

07/2011

Claim of Beneficial Use Map

Application S-86956, Permit S-54624

Elk Lake - William Leet

T.18S. R.8E. Section 29, W.M.