


**FINAL PROOF SURVEY  
CLAIM OF BENEFICIAL USE  
WATER RIGHTS MAP**

MID COAST BASIN  
UNDER  
PERMIT 54688  
APPLICATION NO S-86630  
NW 1/4 SE 1/4, SEC. 11, T19S, R12W, W.M.  
19-12-11-4, TL 124  
LANE COUNTY, OREGON

FOR: ROBERT AND CHENOA SUMMERS  
390 REGAL DRIVE  
HOLLISTER, CA 95023

PREPARED BY: WOBBE & ASSOCIATES, INC.  
510 KINGWOOD ST. / P.O. BOX 3093  
FLORENCE, OR 97439  
DATE: OCTOBER 6, 2011

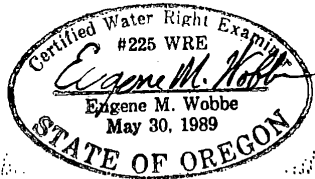

**RECEIVED**

NOV 9 2011  
WATER RESOURCES DEPT  
SALEM, OREGON

**COBU MAP # 0634**  
*folder 5*