


SECTION 25, TWP. 11 S. RANGE 20 E. W.M. WHEELER COUNTY, OREGON

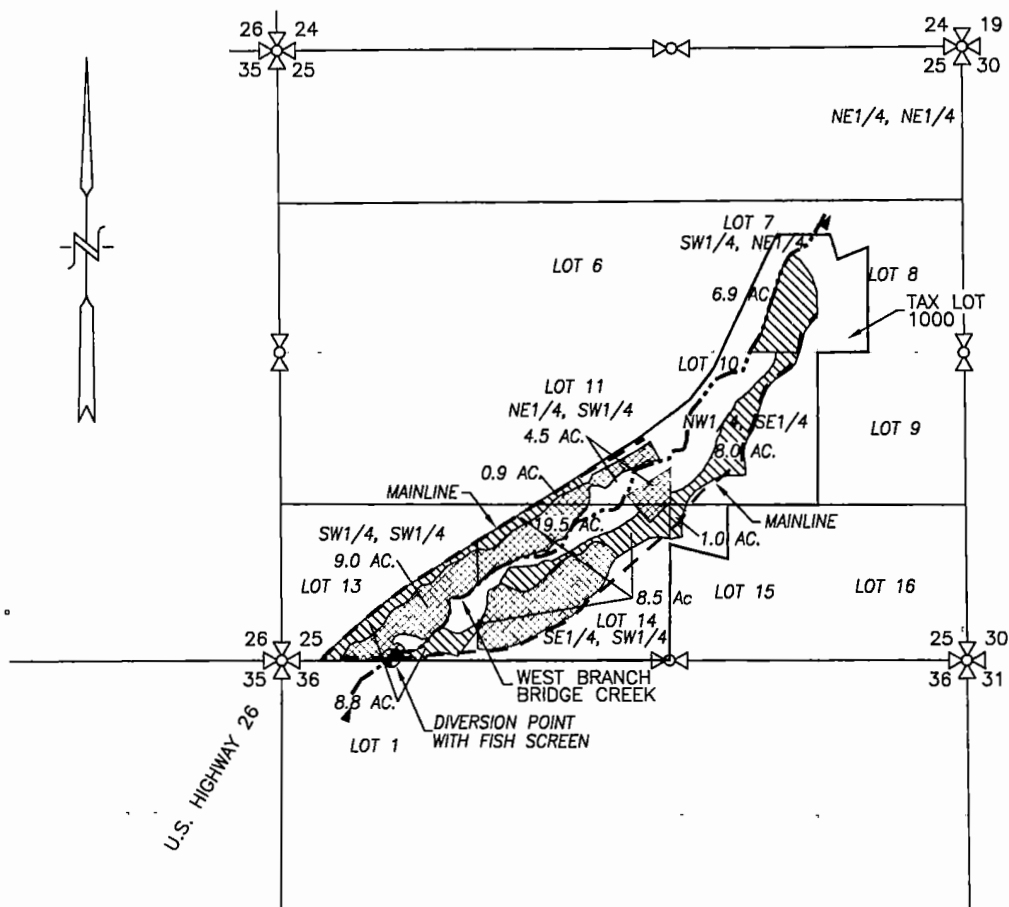

PLACE OF USE FROM O.W.R.D. FINAL PROOF SURVEY MAP BY
J. MILLER FOR APPLICATION 64480 ON MARCH 5, 1992.

LEGEND :

- DIVERSION POINT: 20' NORTH & 950' EAST OF SW COR. SEC. 25
- OLD CERTIFICATE 82387 (34.1 AC.)
- OLD CERTIFICATE 81649 (33.0 AC.)
- IRRIGATION MAIN
- STREAM WITH DIRECTIONAL FLOW


RECEIVED BY OWRD

OCT 04 2012

SALEM, OR

CLAIM OF BENEFICIAL USE MAP

SCALE: 1" = 1320'

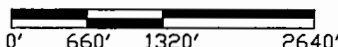


TRANSFER No. 9891

IN THE NAME OF:

JOYCE BROOKS

DATE: SEPTEMBER 17, 2012

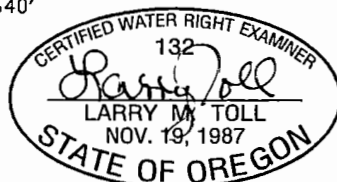

EXPIRES: 06/30/2014

BY: **TENNESON ENGINEERING CORP.**



3313 W. 2ND. STREET, SUITE 100
THE DALLES, OREGON. 97058
PH. 541-296-9177
FAX 541-296-6657




NOTE:

"THIS MAP IS NOT INTENDED TO
PROVIDE DIMENSIONS OR LOCATIONS
OF PROPERTY OWNERSHIP LINES."

W.O. #13849wr

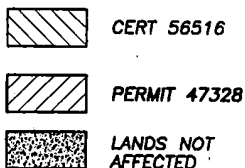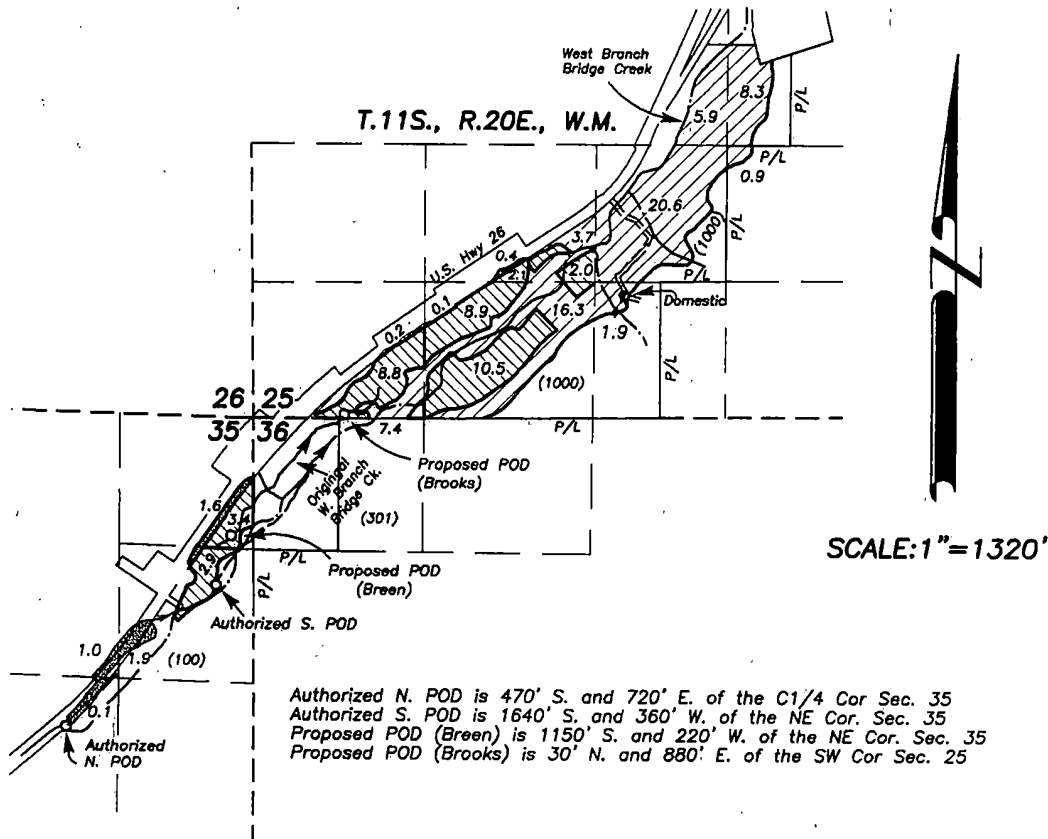

P/L PROPERTY LINE
 () TAX LOT NO.

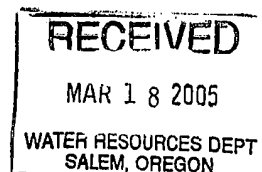

APPLICATION MAP FOR ADDITIONAL POINT OF DIVERSION

FOR


**JAMES BROOKS
 AND
 MICHAEL BREEN**

BY

BAGETT, GRIFFITH & BLACKMAN
 217 N. CANYON BLVD.
 JOHN DAY, OR. 97845
 (541) 575-1251

DECEMBER 7, 2004

NOTE: The preparation of this map was for the purpose of identifying the location of the proposed water right and has no intent to provide dimensions or location of property ownership lines.

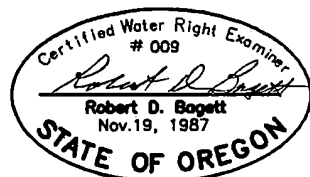

T-9891