



CLAIM OF BENEFICIAL USE MAP
FOR GARY ALFORD
LOCATED IN THE NW1/4 OF THE SE1/4 OF SECTION 17
TOWNSHIP 23 SOUTH, RANGE 12 WEST, W.M.,
COOS COUNTY, OREGON

APPLICATION #S-84661
PERMIT #53821

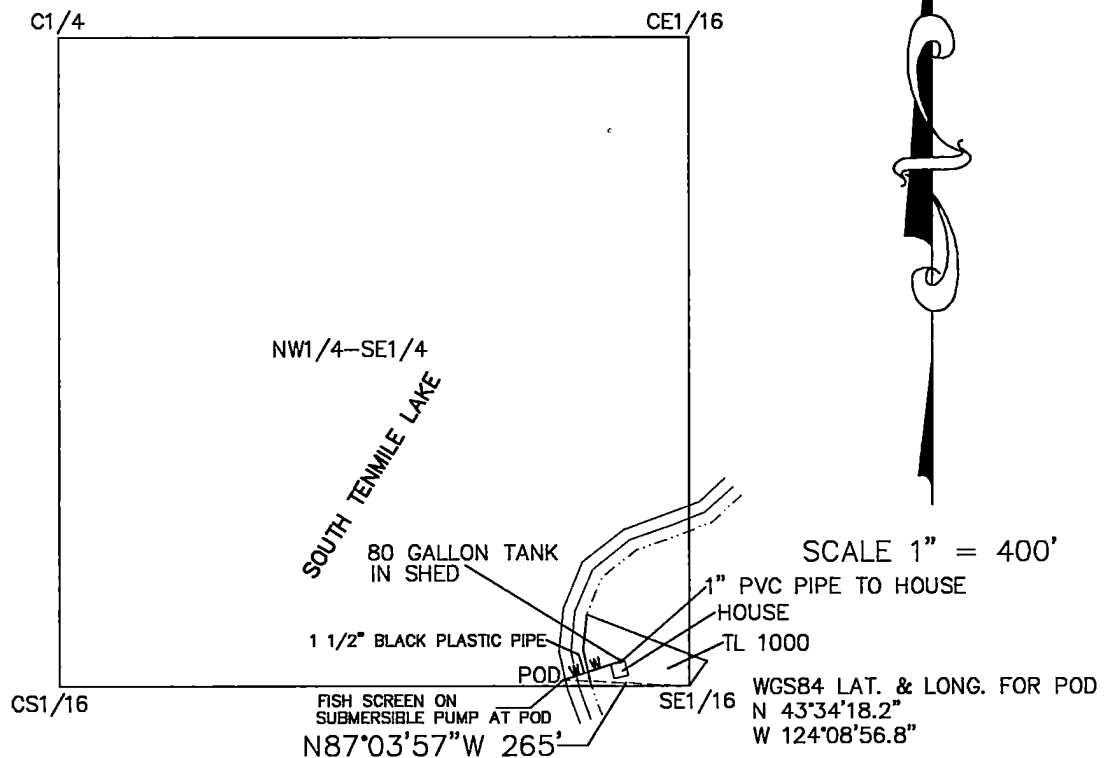

LEGEND:

- POD POINT OF DIVERSION
- TL TAX LOT
- W WATER PIPE LINE

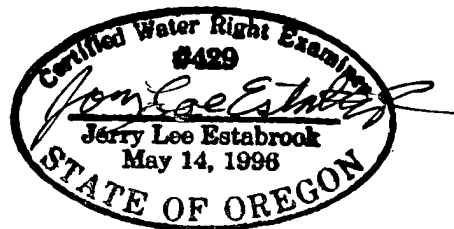

EXPIRES 12/31/15

RECEIVED BY OWRD

MAY 26 2015

SALEM, OR

EXAMINERS DISCLAIMER STATEMENT:

THE PREPARATION OF THIS MAP WAS FOR THE PURPOSE OF IDENTIFYING THE LOCATION OF WATER RIGHT ONLY AND HAS NO INTENT TO PROVIDE DIMENSIONS OR LOCATION OF PROPERTY OWNERSHIP LINES.