



T. 13 S., R. 5 W., W. M.

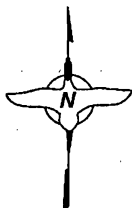

MAP TO ACCOMPANY CLAIM OF BENEFICIAL USE FOR APPLN R-87126, PER R-14716 IN THE NAME OF THE U.S.FISH & WILDLIFE SERVICE, WM. FINLEY NATIONAL WILDLIFE REFUGE

OREGON STATE PLANE GRID NORTH  
(NORTH ZONE,  $\theta = -2^{\circ} 00' 08.2''$ )  
1 INCH = 400 FEET

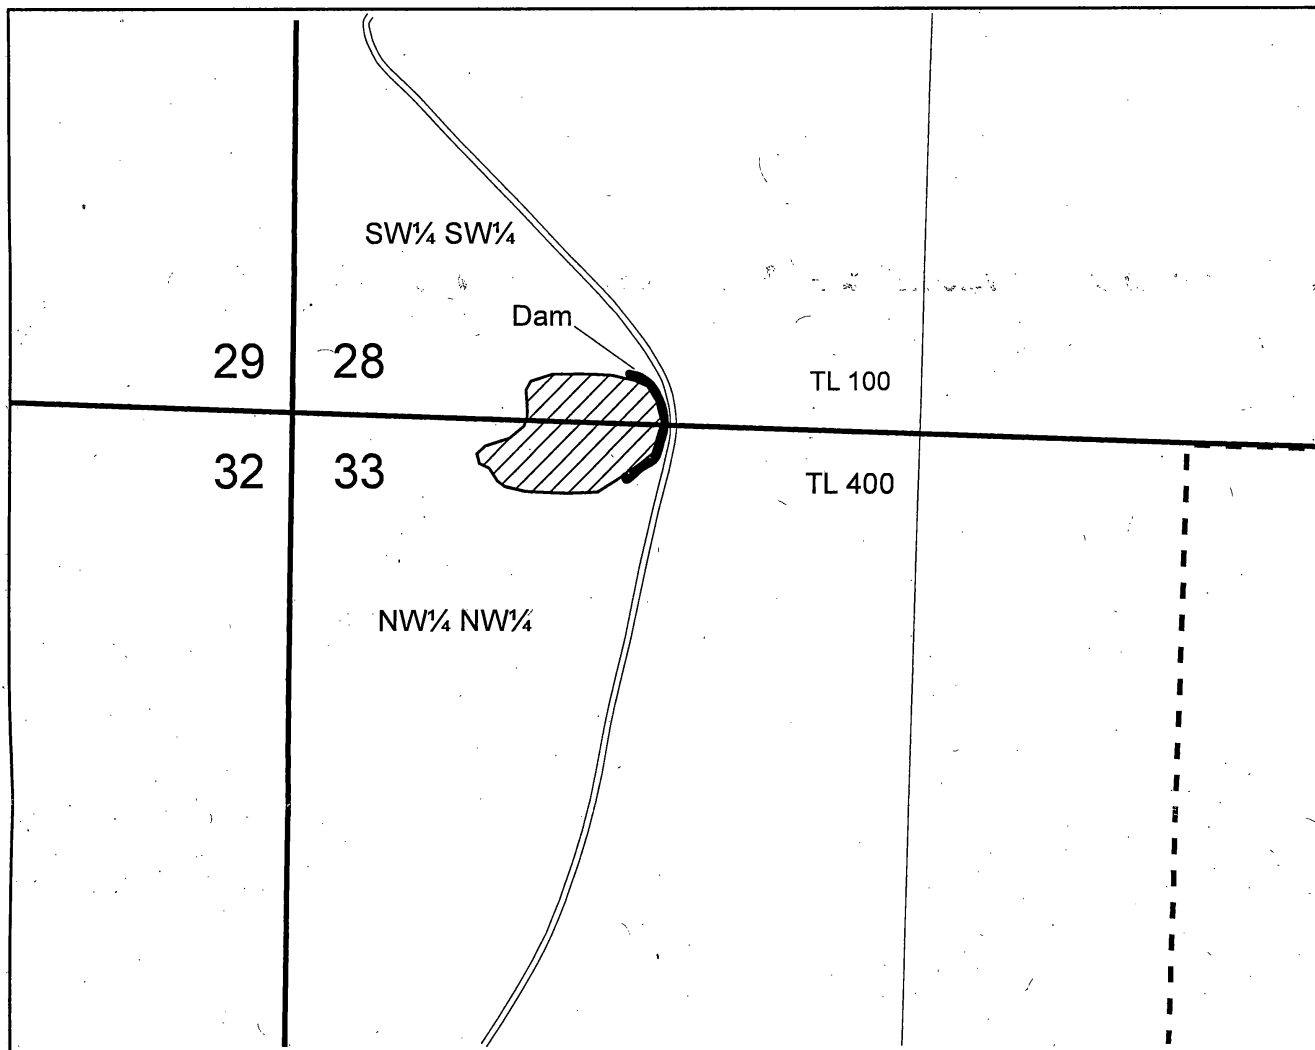

Yellowlegs Pond Place of Use



Section Line



Refuge Boundary Line



1/4-1/4 Line

RECEIVED

JAN 20 2015

OWRD



RENEWS: 12/31/2015

This map is not intended to provide legal dimensions or locations of property ownership lines.