

Final Proof Survey T15S R3W, W.M.

This map is not intended to provide legal dimensions or locations of property ownership lines.

Transfer T-10862

In the name of
**Muddy Creeks
Irrigation Project**

Transfer To:
Certificate #68366





Prepared by
**Walter L. Trimmer
CWRE #332
Trimmer Engineering Inc.**

3924 NW Walunt Place
Corvallis, OR 97330
541-754-2819

Scale 1" = 1320'

April 2, 2013
Layout: CBUU-10862_1
File: MuddyCrks.dwg
Based on USGS Harrisburg Quad

DWG 1 of 4

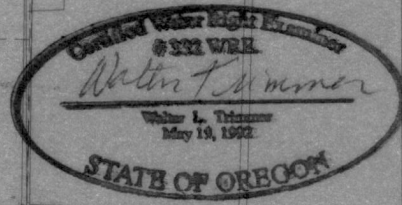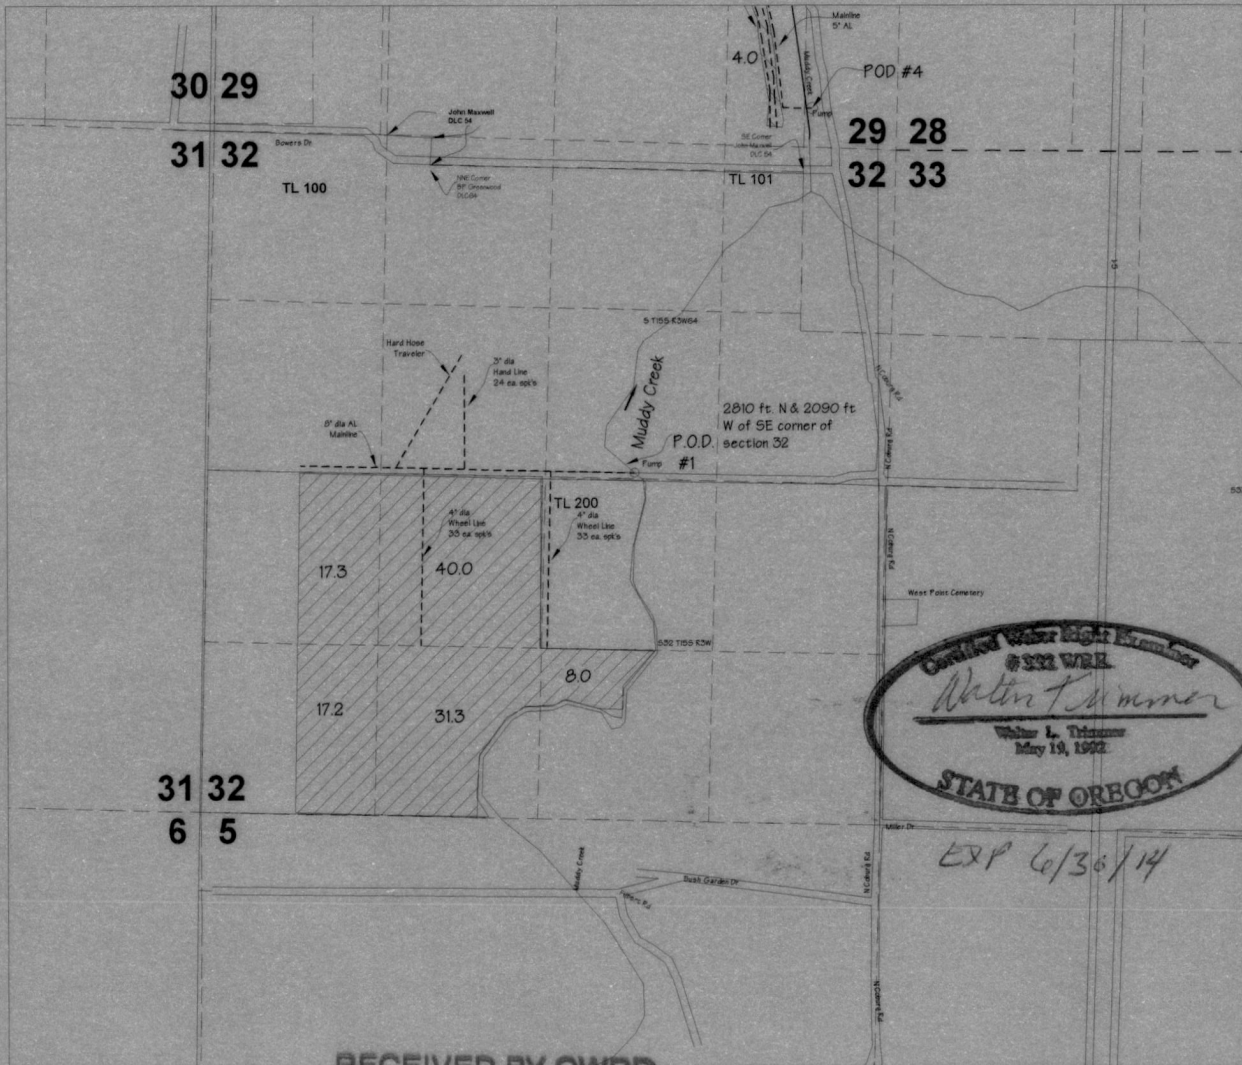

EXP 6/30/14

RECEIVED BY OWRD

APR 03 2013

SALEM, OR

Final Proof Survey T14S R4W, W.M.

This map is not intended to provide legal dimensions or locations of property ownership lines.

Transfer T- 10862

In the name of
**Muddy Creeks
Irrigation Project**

Transfer To:
Certificate #68366





Prepared by
Walter L. Trimmer
CWRE #332
Trimmer Engineering Inc.
3924 NW Walunt Place
Corvallis, OR 97330
541-754-2819

Scale 1" = 1320'

April 2, 2013
Layout: CBU-10862_2
File: MuddyCrks.dwg
Based on USGS Halsey Quad

DWG 2 of 4

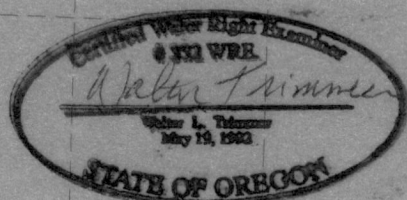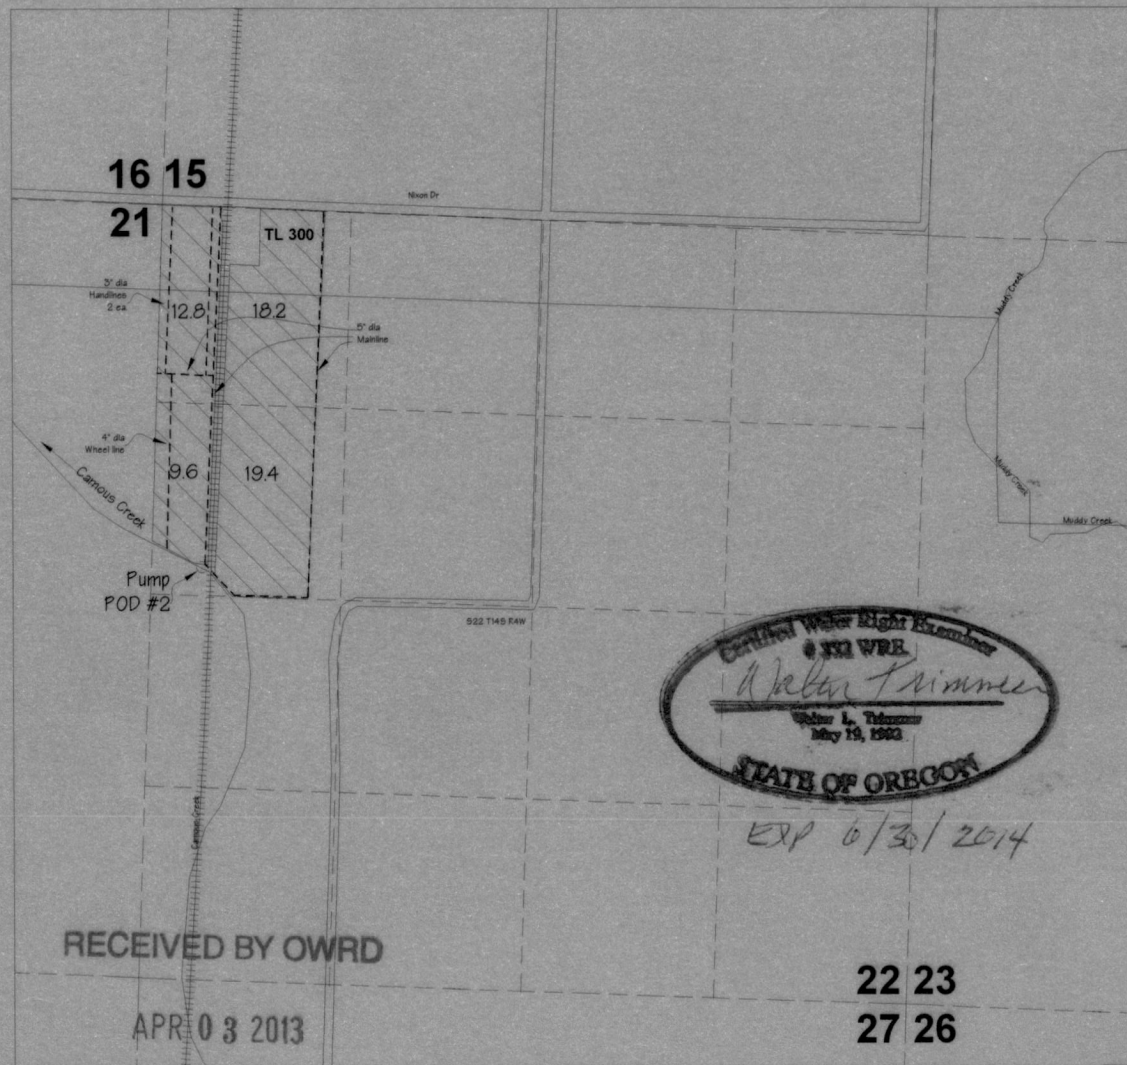

EXP 6/30/2014

Final Proof Survey T15S R3W, W.M.

This map is not intended to provide legal dimensions or locations of property ownership lines.

Transfer T-10862

In the name of
**Muddy Creeks
Irrigation Project**

Transfer To:
Certificate #68366




Prepared by
Walter L. Trimmer
CWRE #332
Trimmer Engineering Inc.
3924 NW Walunt Place
Corvallis, OR 97330
541-754-2819

Scale 1" = 1320'

April 2, 2013
Layout: CBU-10862_3
File: Muddy_Crks.dwg
Based on USGS Coburg Quad

DWG 3 of 4

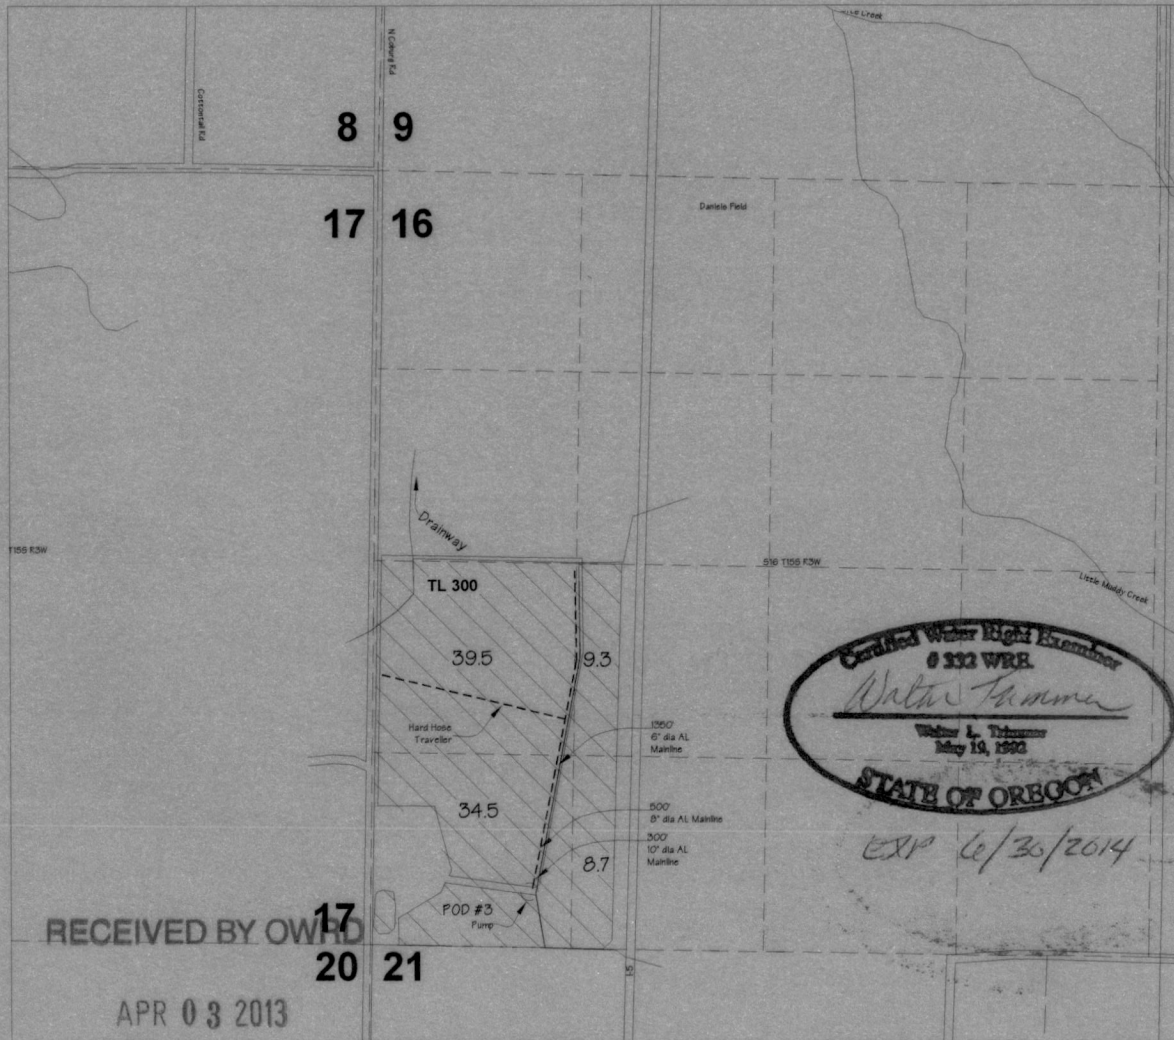

RECEIVED BY OWH

APR 03 2013

SALEM, OR

This map is not intended to provide legal dimensions or locations of property ownership lines.


Final Proof Survey T15S R3W, W.M.

Transfer T- 10862

RECEIVED BY OWRD

APR 03 2013

SALEM, OR

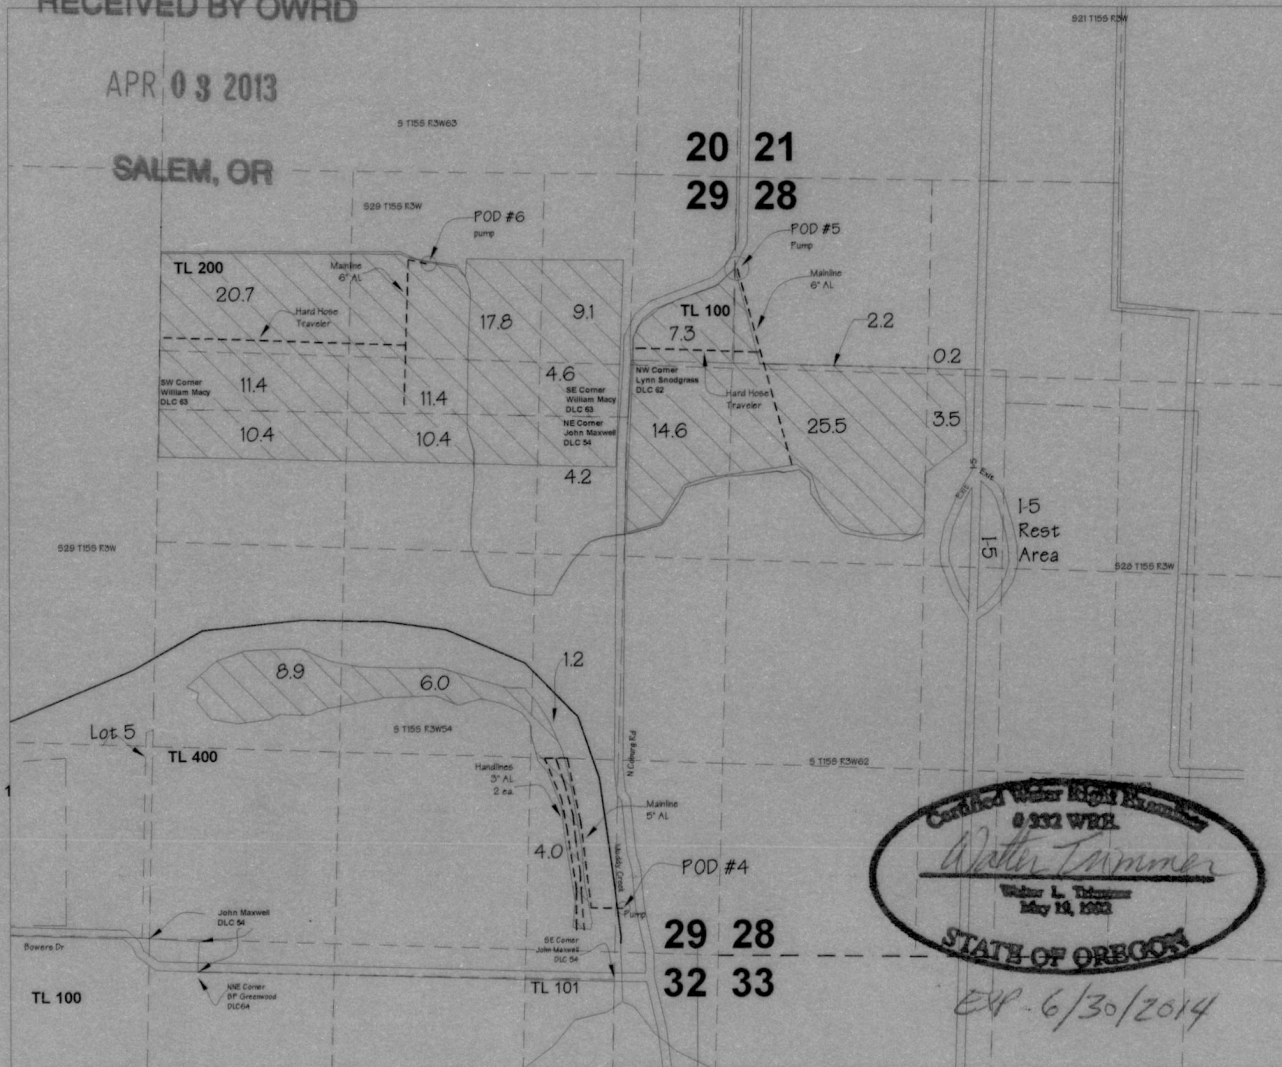

In the name of
**Muddy Creeks
Irrigation Project**

Transfer To:
Certificate #68366



Prepared by
**Walter L. Trimmer
CWRE #332
Trimmer Engineering Inc.**
3924 NW Walunt Place
Corvallis, OR 97330
541-754-2819

Scale 1" = 1320'

April 2, 2013
Layout: CBU-10862_4
File: Muddy_Crks.dwg
Based on USGSCoburg Quad

DWG 4 of 4