
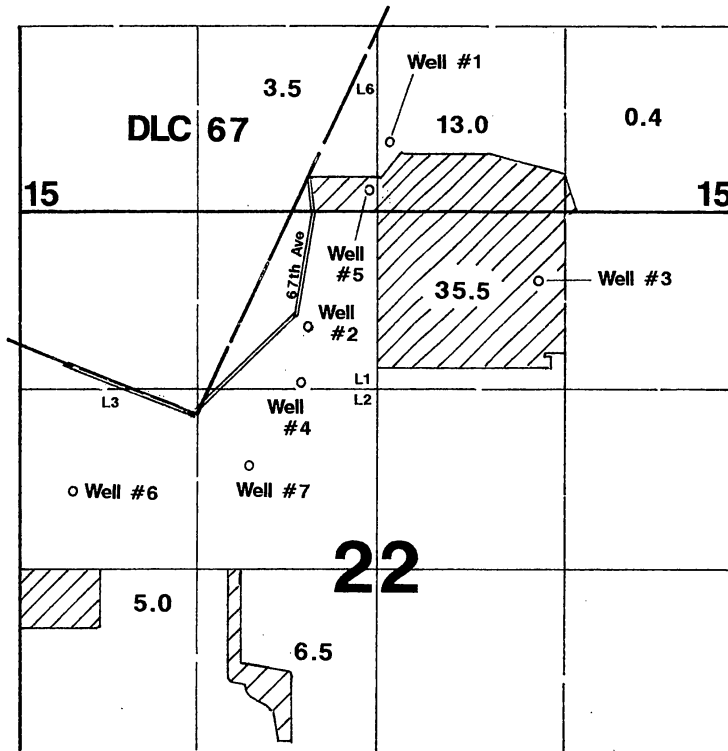


T.6S. R.2W., W.M

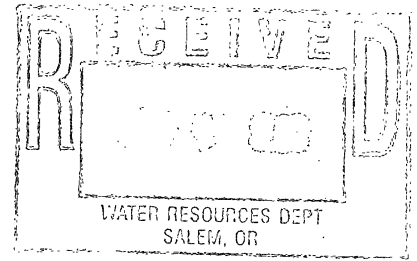

Well # 1 is located 500'N & 2530'W from the SE corner of Section 15.
 Well # 2 is located 750'S & 470'W from the N1/4 corner of Section 22.
 Well # 3 is located 500'S & 1450'W from the NE corner of Section 22.
 Well # 4 is located 1350'N & 550'W from the center of Section 22.
 Well # 5 is located 150'N & 50'W from the N1/4 corner of Section 22.
 Well # 6 is located 540'N & 400'E from the W1/4 corner of Section 22.
 Well # 7 is located 750'N & 1700'E from the W1/4 corner of Section 22.

Final Proof Survey

Application: G-13285 Permit #: G-12468

In Name Of

Greg Bennett

Surveyed on July 31, 2000 by JM Schuette

This Map Was Prepared For The Purpose Of Identifying The Location Of A Water Right Only And Is Not Intended To Provide Legal Dimensions Or Location Of Property Ownership Lines.

