

1045


Map of
Claim of Beneficial Use
Application G-16105
Permit G-15626

RECEIVED

SEP 10 2018

OWRD

T 39 S, R 10 E, Sec. 16, 17, 20 & 21 W.M.

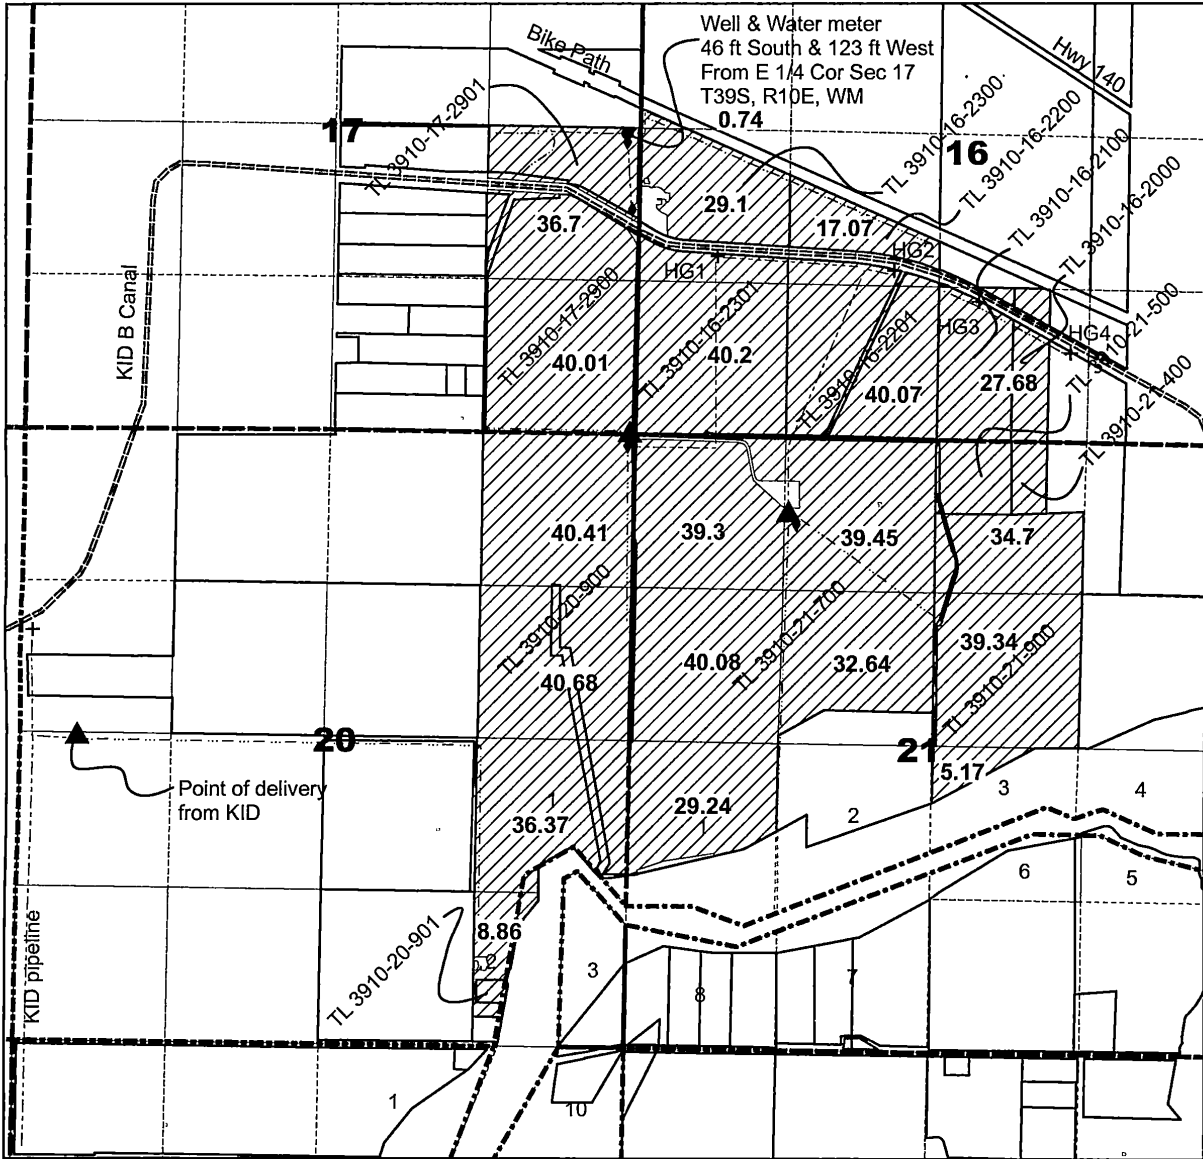


Legend

- Area irrigated by G-15626
- Water meter
- Head gate
- Pump station
- Pump supply pipeline
- Sprinkler mainline
- Flood pipelines
- Flood ditch
- KID B Canal

Note: This map is not intended to provide legal dimensions or locations of property ownership lines.



1 inch = 1,320 feet

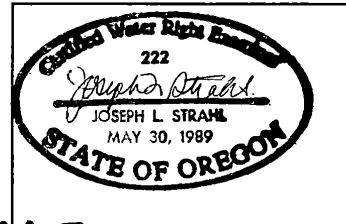

1045