


SEC. 10, T.23S., R.31E., W.M.

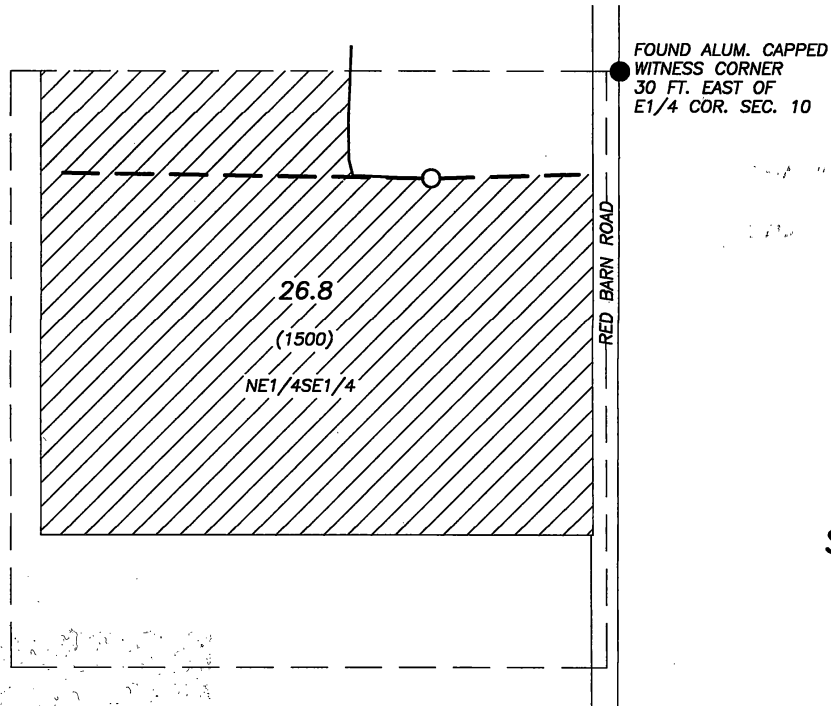

POA-WELL #1 & FLOW METER 240 FT. SOUTH & 390 FT. WEST
OF THE E1/4 COR. SEC. 10, T.23S., R.31E., W.M.

NOTE: FOUND WITNESS CORNER MONUMENT WITH ALUMINUM CAP
30 FT. EAST OF E1/4 COR. SECTION 10

FINAL PROOF SURVEY

UNDER

APPLICATION NO. G-17101

PERMIT NO. G-16517

IN NAME OF

JANICE BAILEY



CURRENT PLACE OF USE



WELL #1 - INLINE FLOW METER IS 5' WEST



BURIED MAINLINE WITH RISERS

(1500) TAX LOT NO.

RECEIVED BY OWRD


NOV 30 2015

SALEM, OR

PREPARED BY

ROBERT D. BAGETT
217 N. CANYON BLVD.
JOHN DAY, OR 97845

DATE SURVEYED: OCT. 30, 2015

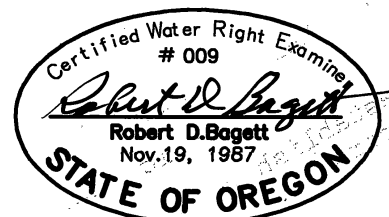

DISCLAIMER: THIS MAP IS NOT INTENDED TO PROVIDE LEGAL
DIMENSIONS OR LOCATIONS OF PROPERTY OWNERSHIP LINES.

RENEWS: 12/31/2015