
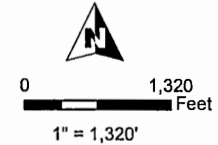


T27S, R30E, SEC 35 WM


HARNEY COUNTY, OREGON

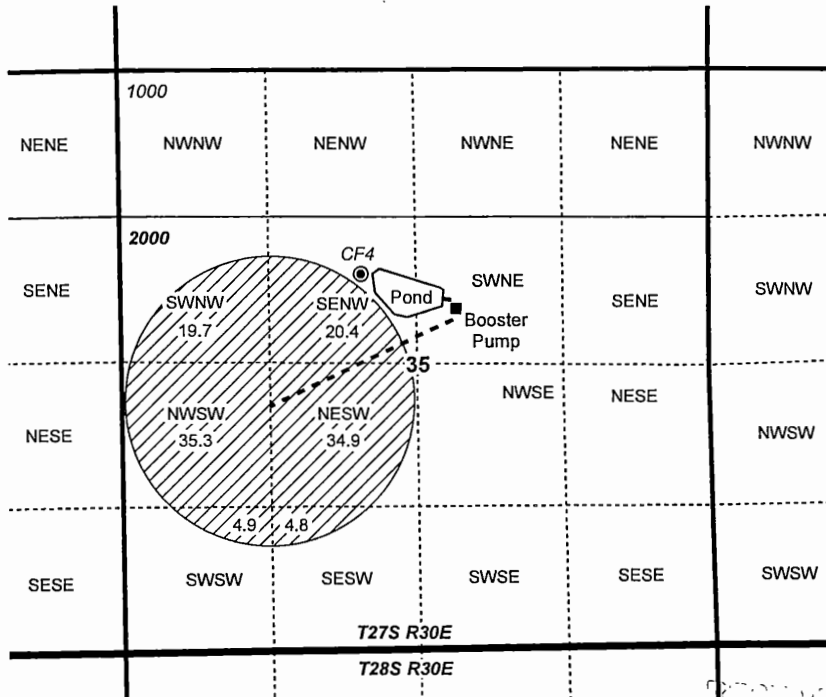

- POU IR
- Township
- Section
- Quarter Quarter
- Tax Lot
- Well & Meter

WELL LOCATION:

CF4: 3,300' N, 3,168' W OF SE COR SEC 35

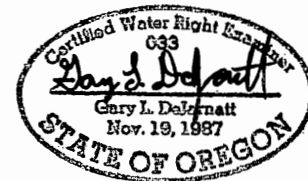

RENEWAL DATE 12/31/2019



CLAIM OF BENEFICIAL USE MAP
Sherburn - Coyote Flat Ranch

AP G-17531

PERMIT G-16980

NOTE: THIS MAP IS NOT INTENDED TO
PROVIDE LEGAL DIMENSIONS OR LOCATIONS
OF PROPERTY OWNERSHIP LINES.

JOB # 17067

FEBRUARY 20, 2018

WATER RIGHT SERVICES, LLC

PO BOX 1830, BEND, OR 97709

CCB# 197121 www.oregonwater.us

541-389-2837 JOHNSHORT@USA.COM