


# T. 6S. R. 39E. W.M.

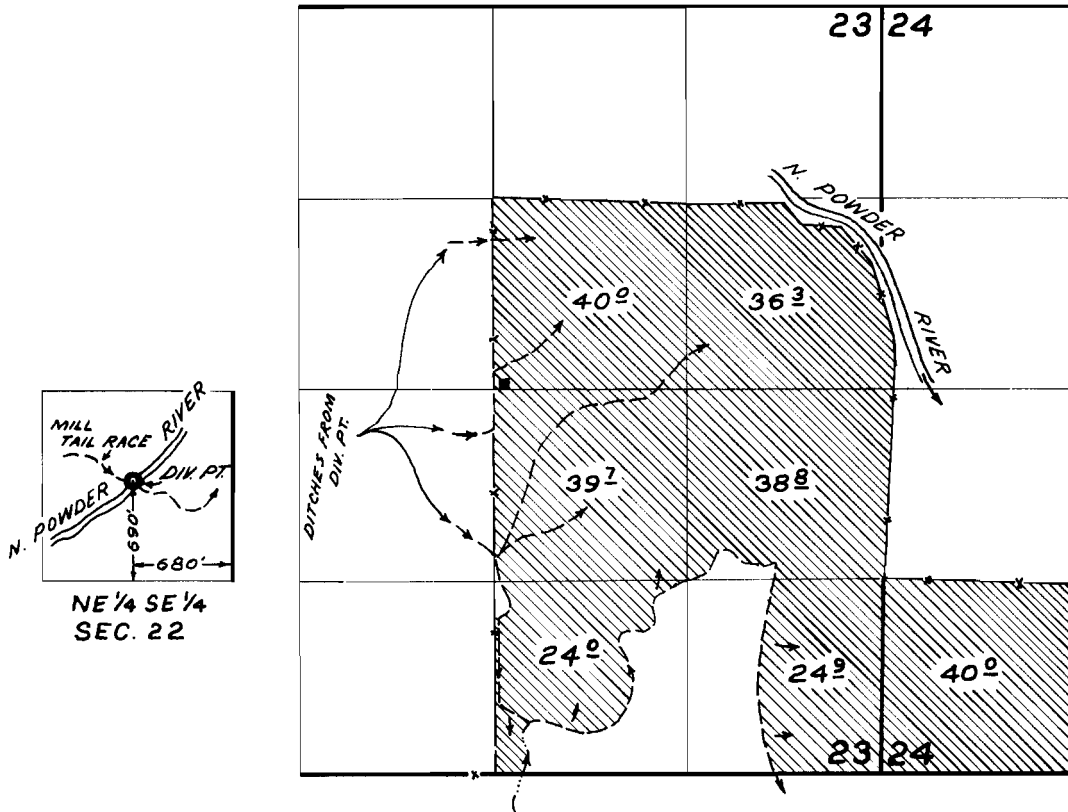

## FINAL PROOF SURVEY UNDER

Application No. 12337 Permit No. 8754

IN NAME OF

WILLIAM E. & VIVIAN C. DAVIS

Surveyed Nov. 13, 1964, by R. JACKSON