



Claim of Beneficial Use Map
 NW1/4, NW 1/4, Section 11
 Township 1S, Range 4E, W.M.
 Irrigation Use: 20.0 Acres

Permit #: G-15849
 Application #: G-16305

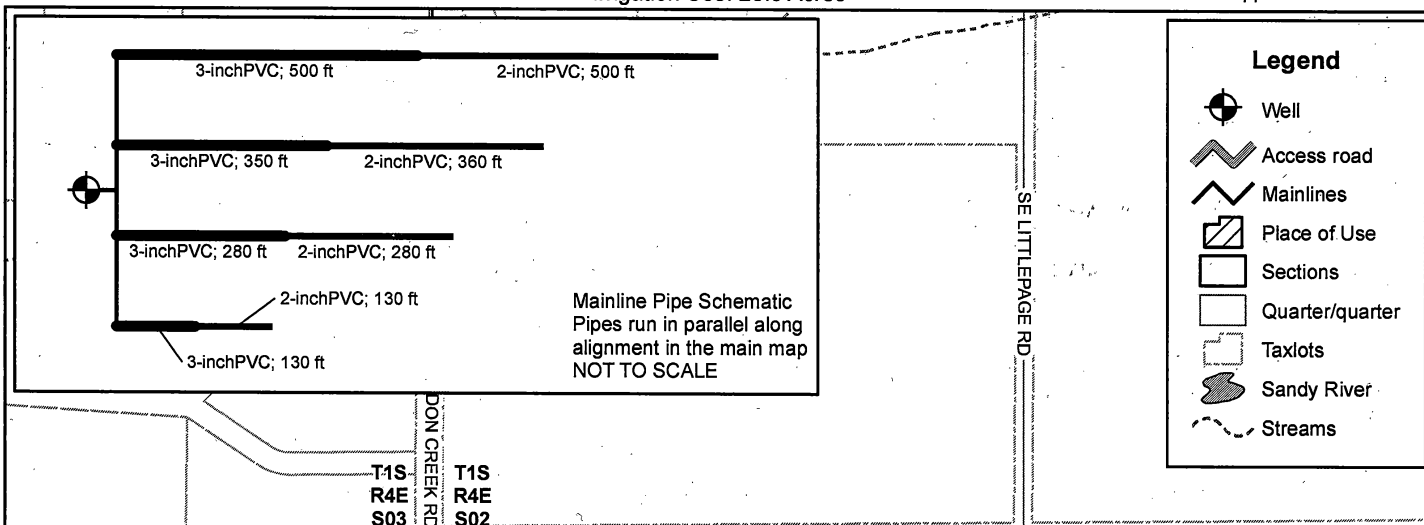

Legend

- Well
- Access road
- Mainlines
- Place of Use
- Sections
- Quarter/quarter
- Taxlots
- Sandy River
- Streams

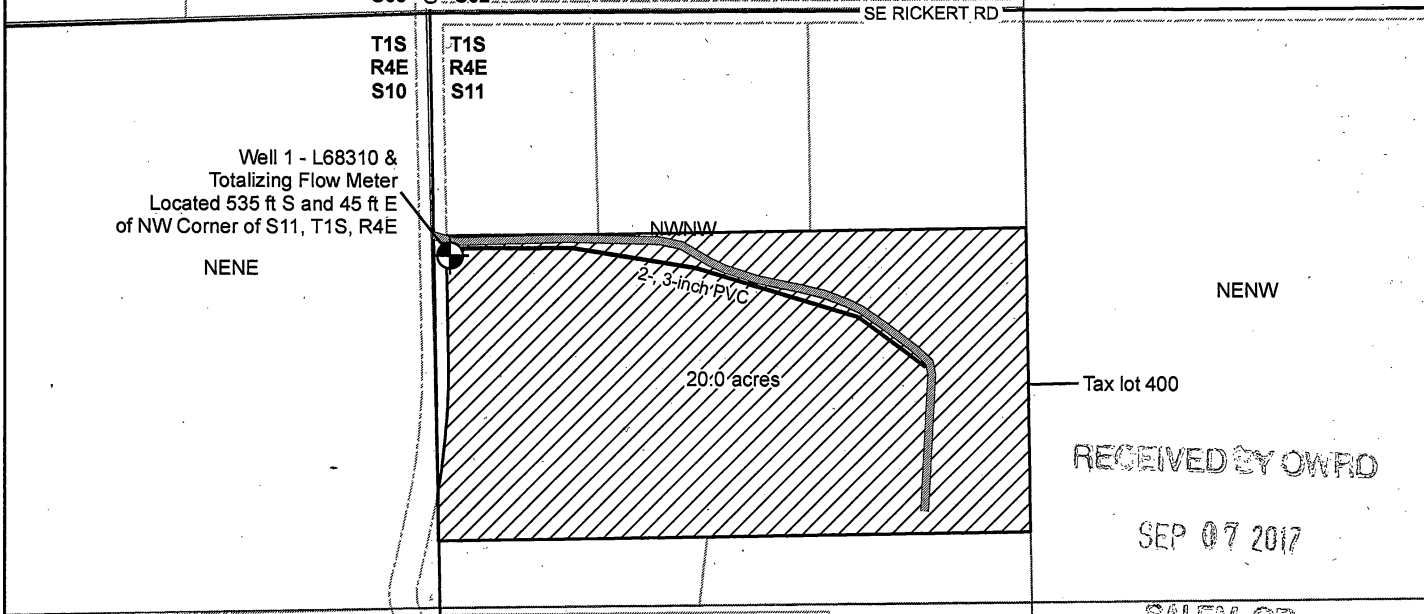

RECEIVED BY OWRD
 SEP 07 2017
 SALEM, OR


Certified Water Rights Examiner
 #71101
REL
 Robert E. Long Jr.
 May 15, 2002
 STATE OF OREGON
 EXPIRATION DATE: 12/31/2017

C:\001_CwM_P\Projects\1608001_Sturm\gis\002_maps

CWM-H2O
 Complete Water Management

415 Colony Drive
 Portland, Oregon 97219
 (503) 893-5937

This map is not intended to provide legal dimensions or property ownership lines.

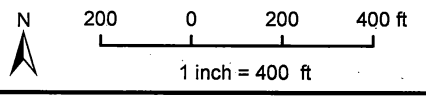

1	01/21/17	RMS	DRAFT
No.	Date	By	Revisions

Proj#: 1608001
 Sturm Berry Farm
 Donald Sturm
 PO Box 245
 Corbett, OR 97019