

T. 38 S., R. 4 W., W.M.


**RECEIVED**

MAR - 8 1995

WATER RESOURCES DEPT.  
SALEM, OREGON

ENE COR.  
DLC No. 38

ELL COR.  
DLC No. 38

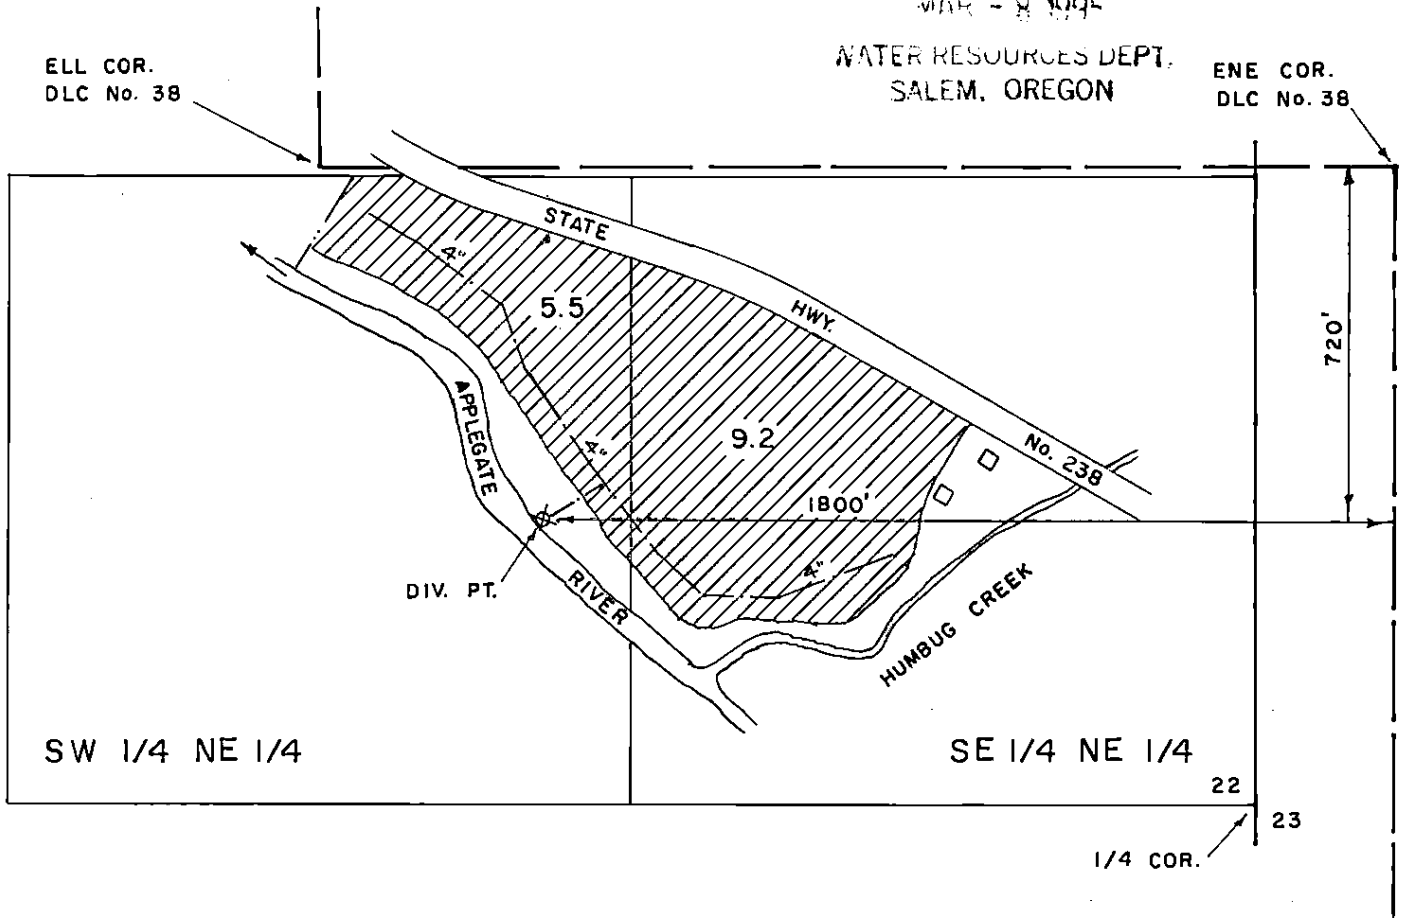


**FINAL PROOF MAP**

TRANSFER No. T-6515

IN THE NAME OF

LEROY LUND

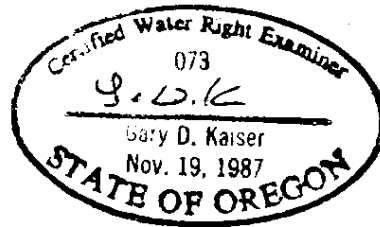

MAP PREPARED FEBRUARY 22, 1995

BY GARY D. KAISER

SCALE: 1" = 400'

NOTE: MAP PREPARED FOR  
WATER RIGHT PURPOSES ONLY,  
NOT FOR PROPERTY BOUNDARY  
LOCATIONS.