


T. 16 S., R. 16 E., W.M.
SE 1/4 SW 1/4

PERMIT G-12319
FINAL PROOF MAP

RECEIVED

JUL 25 2000

ARMSTRONG SURVEYING & ENGINEERING, INC.

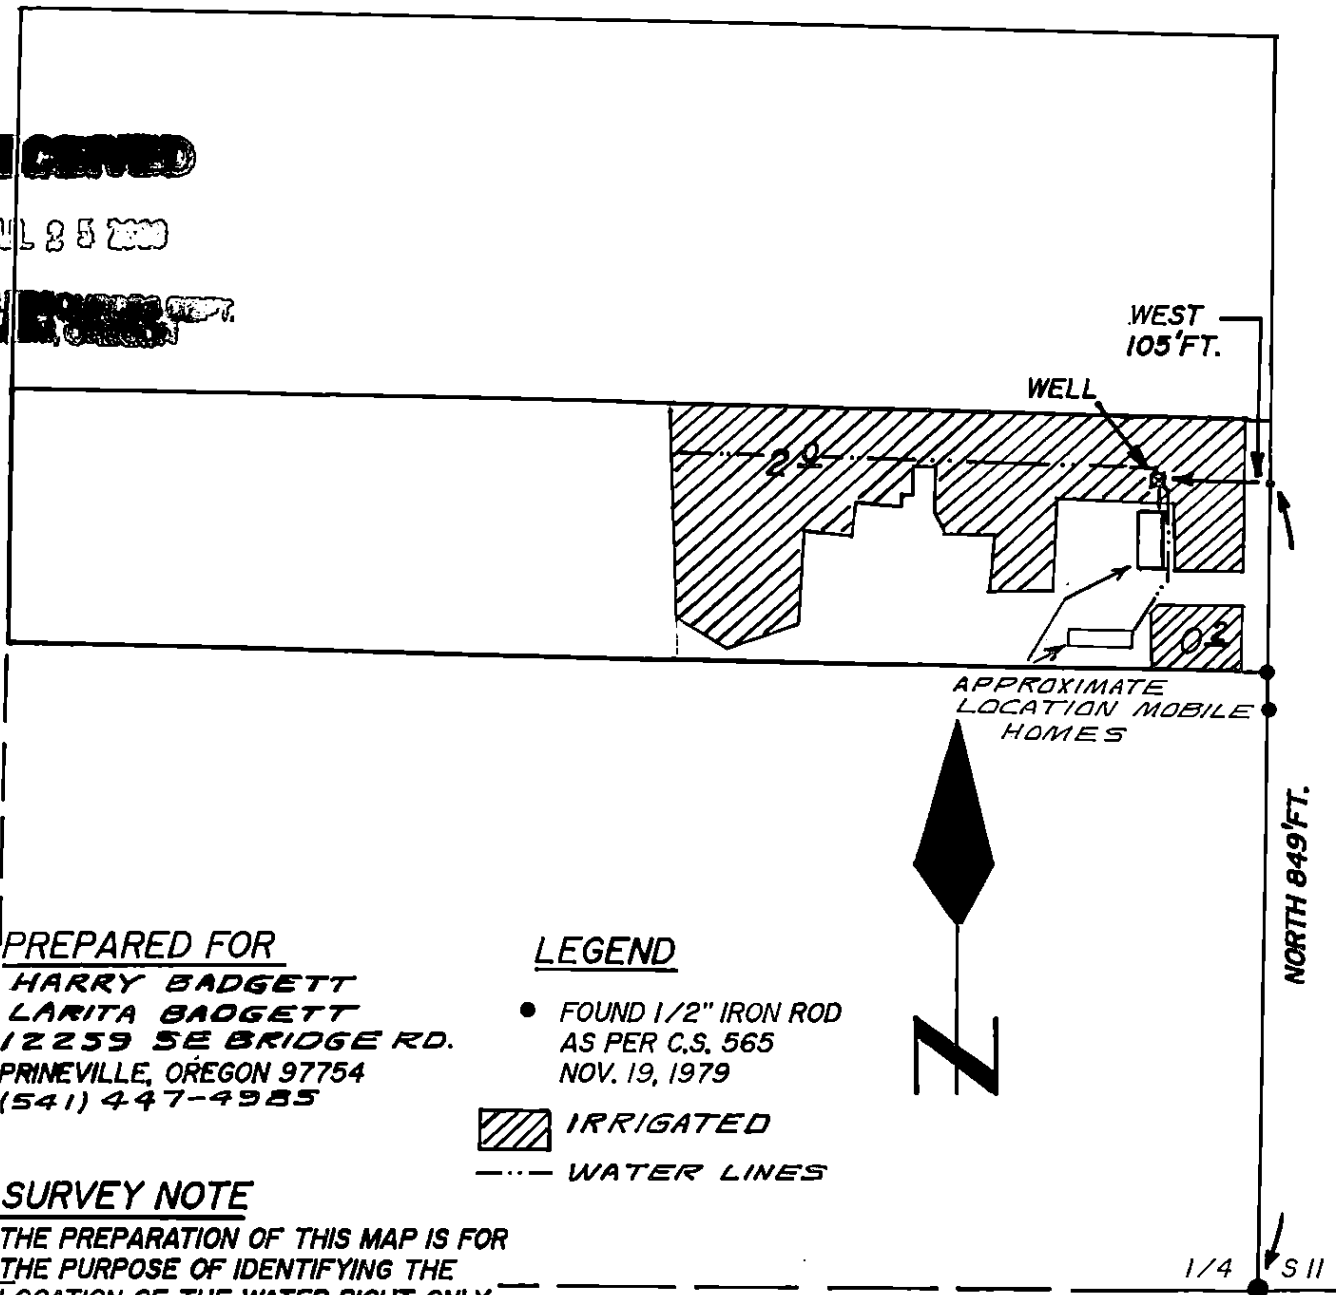

PREPARED FOR

HARRY BADGETT
LARITA BADGETT
12259 SE BRIDGE RD.
PRINEVILLE, OREGON 97754
(541) 447-4985

LEGEND

- FOUND 1/2" IRON ROD
AS PER C.S. 565
NOV. 19, 1979



IRRIGATED



WATER LINES

SURVEY NOTE


THE PREPARATION OF THIS MAP IS FOR
THE PURPOSE OF IDENTIFYING THE
LOCATION OF THE WATER RIGHT ONLY
AND HAS NO INTENT TO PROVIDE
DIMENSIONS OR LOCATIONS OF
PROPERTY OWNERSHIP LINES.

FND. 3-1/4" B.C.
B.L.M.-1985

**ARMSTRONG SURVEYING
& ENGINEERING, INC.**

378 NE SECOND STREET
PRINEVILLE, OREGON 97754

(541) 447-7791

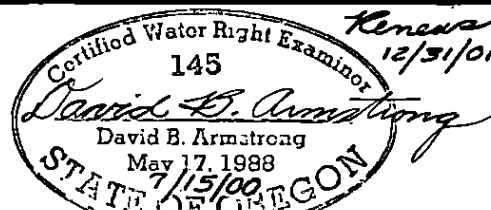

SCALE 1" = 200'

DATE: 7-15-2000

W.O. 00-2080