

SUPERSEDING

T 3 S R 39 E

9 10

GEKELER

10

11

LANE

16

15

15

14

4.6  
Ac.

(38.0) Ac.  
3S 39  
TL #4302,4303

(38.4) Ac.

38.6 Ac.

37.1 Ac.

39.1 Ac.

37.5 Ac.

(40.0) Ac.

(40.0) Ac.

(38.4) Ac.

(37.1) Ac.

(39.1) Ac.

(31.5) Ac.

(10.8)  
Ac.

PIVOT 1

3S 39  
TL #4300

3S 39  
TL #4304

10" PVC

10" PVC

8" PVC

6" PVC

DITCH

1272'

WELL / METER

SLOUGH

(38.0) Ac.

(38.0) Ac.

CREEK



16

15

15

14

(40.0) Ac.

(40.0) Ac.

PIVOT 4

TL #4302

(36.0) Ac.


(26.8) Ac.

CATHERINE

SCALE: 1"=1320'



Lands with Primary rights under Certificate number 46520 and supplemental rights from well.

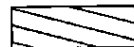

Lands with Primary rights under Certificate number 37041 and supplemental rights from well.



Lands with Primary rights under Certificate number 34924 and supplemental rights from well Owned by Duyck.

Existing mainline

SUPERSEDING

MAY 11, 2018


### FINAL PROOF MAP FOR WATER RIGHTS FROM A WELL

FOR

WILLIAM E. & BARBARA L. DUYCK

BY

BAGETT - GRIFFITH & BLACKMAN  
2006 ADAMS AVENUE  
LAGRANDE, OREGON 97850

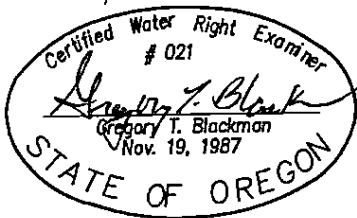

NOTE: The preparation of this map was for the purpose of identifying the location of the proposed water right and has no intent to provide dimensions or location of property ownership lines. Location information shown hereon was furnished by the applicant.

APPLICATION NO. G- 13921

PERMIT NUMBER G- 12737

RECEIVED

MAY 23 2018

OWRD