
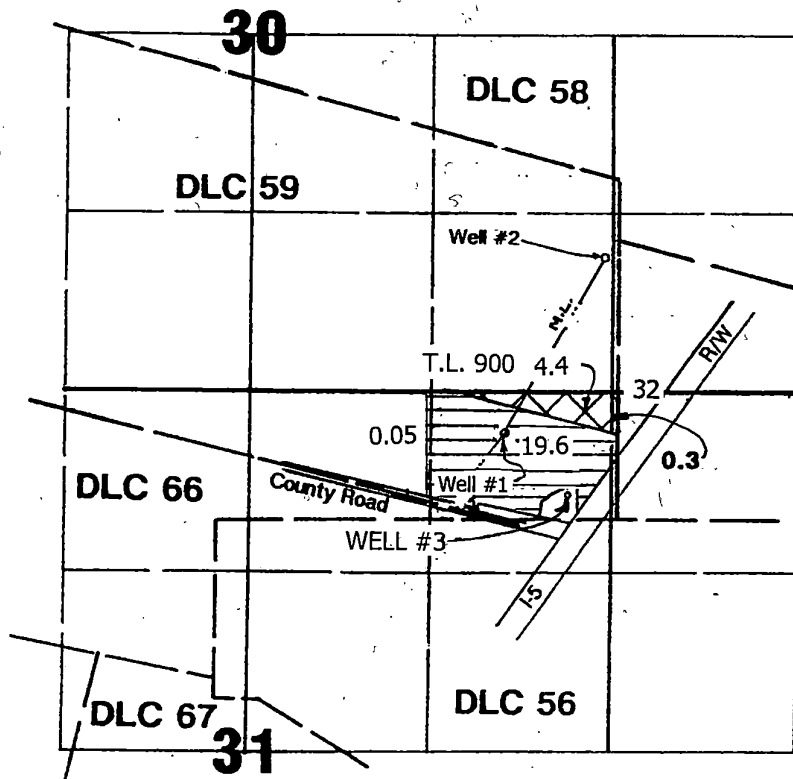


FINAL PROOF SURVEY MAP IN THE NAME OF
THOMAS H. DeARMOND

T 4 S, R 1 W, W.M. Section 30 & 31 & 32

T-10071


- Section line
- 1/4 1/4 line
- DLC line
- Pipe line
- Tax Lot line

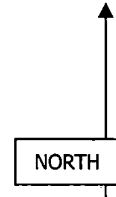

- OWRE Well #1: 607' N & 812' W from the SE corner of DLC 59
- OWRE Well #2: 1000' N & 50' W from the SE corner of section 30
- OWRE Well #3: 220' N & 400' W from the SE corner of DLC 59

Scale 1" = 1320'

This map is not intended to provide dimensions or locations of property ownership lines.

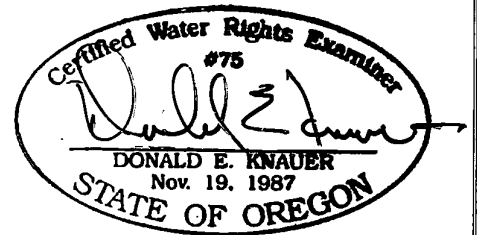

RENEWAL DATE: 6/30/2015