


T6N, R35E, WM  
Sections 26-27  
Umatilla County

1 inch = 1320 feet

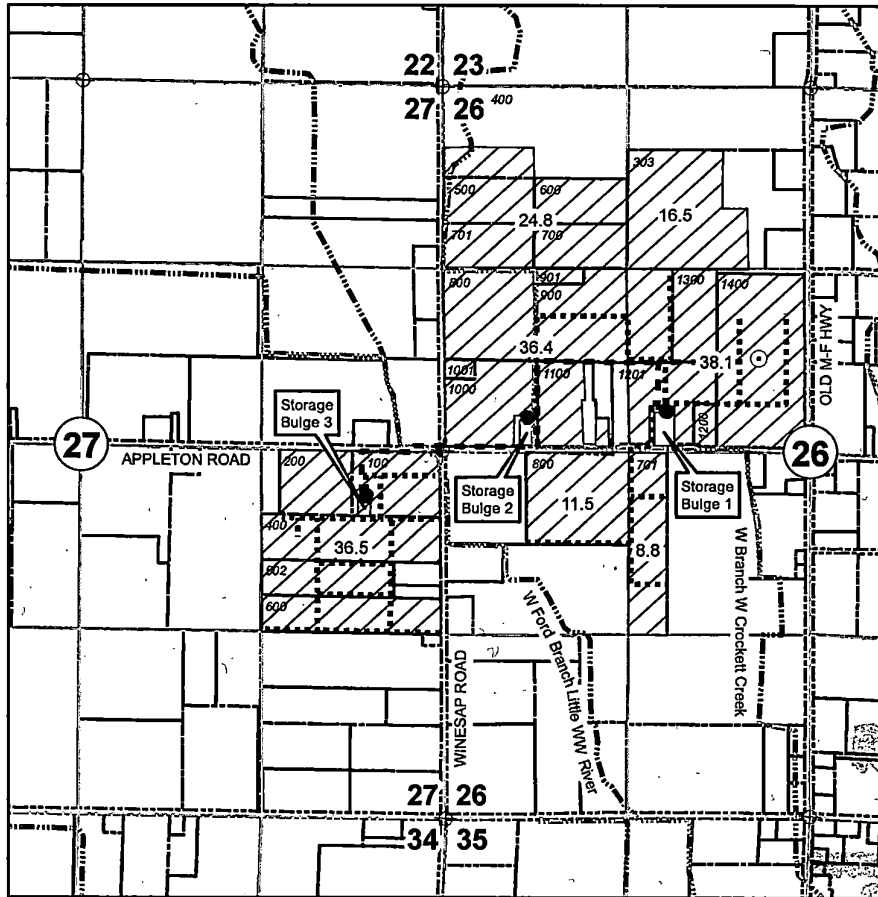

APR 14 2008

○ **Authorized POA**

Groundwater well located SE/4 of NW/4 of Section 26, about 700 feet N and 415 feet W from Center of Section 26. Well is constructed in basalt aquifer (Well Logs UMAT 54524 and UMAT 54779). Flowmeter is located 10 feet south of well.

● **Pumps**

Pumps located downstream of storage bulges.

---- **Conveyance (POA to Bulges)**

Buried pipelines (12, 10 and 8-inch) convey water from POA (well) to three storage bulges.

..... **Conveyance (Bulges to POU)**


Buried pipelines (10, 8, 6, 5 and 4-inch) convey water from three storage bulges to place of use.

Water applied to apple orchards with Nelson R10 sprinklers mounted under-tree for irrigation and over-tree for temperature control.

 **Place of Use**

172.6 acres, including:  
16.5 ac in NE/4 NW/4 S26  
24.8 ac in NW/4 NW/4 S26  
36.4 ac in SW/4 NW/4 S26  
38.1 ac in SE/4 NW/4 S26  
8.8 ac in NE/4 SW/4 S26  
11.5 ac in NW/4 SW/4 S26  
36.5 ac in NE/4 SE/4 S27

purpose of this map is to identify the location of a water right. It is not intended to provide information regarding the location of property ownership boundary

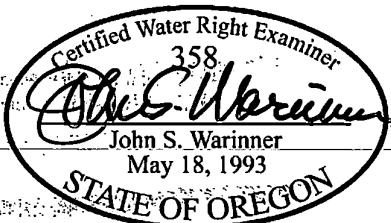

**FOUNTAINHEAD**  
1860 Blue Creek Road  
Walla Walla, WA 99362  
509.529.2646 phone

**COBU MAP**  
**Application G-15721**  
**Permit G-15280**

in the name of  
**DAVIS ORCHARDS**

Revised 02 APR 2008