



TAXLOT 103, S4, T2N, R2W, WASHINGTON COUNTY
Appl S-87341, Permit S-54766

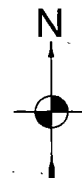

1 IN = 400 FT




A horizontal scale bar with a black and white alternating pattern. It is marked with '0' at the left end, '200' in the middle, and '400' at the right end.

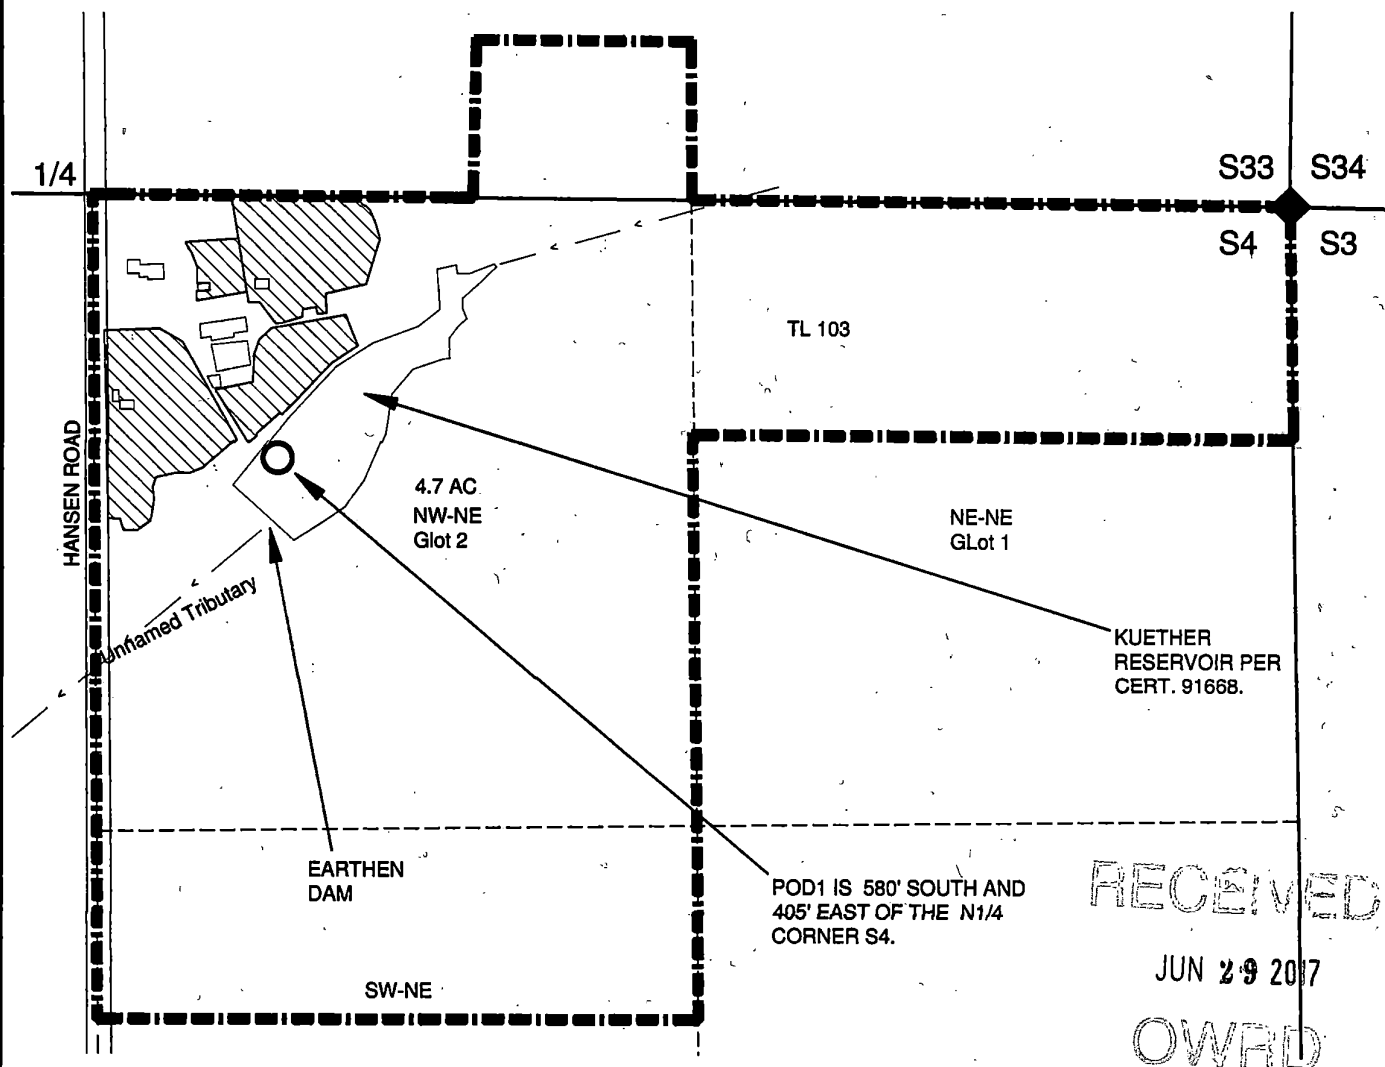

-WATER CONVEYANCE LINES SHALL BE ALL WITHIN THE PROPERTY AND THEREFORE ARE NOT SHOWN.

Glott **GOVERNMENT LOT**

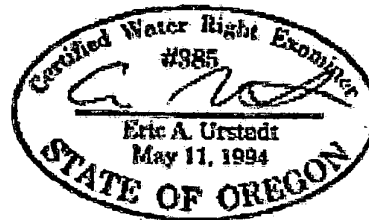

Kuether1 C