
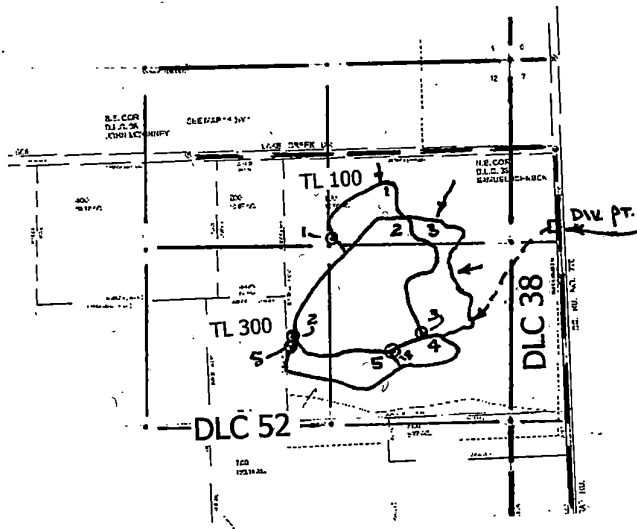


FINAL PROOF SURVEY MAP
 IN THE NAME OF
 RIVER REFUGE SEED, LLC.
 T 14 S, R 3 W, W.M. Section 12

Application R-87865 Permit R-15055

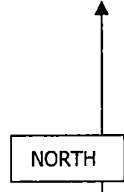

Div. Pt.: 1210' S & 330' E

- Reservoir Locations:
- 100-1 1260' S & 1280' W
 - 100-2 1950' S & 1550' W
 - 100-3 1980' S & 610' W
 - 100-4 2120' S & 850' W
 - 100-5 2060' S & 1590' W
- All from the NE cor. Sec. 12
 All within DLC 52


- DLC Line
- Section line
- 1/4 1/4 line
- Tax Lot line
- Drain ditch
- Outlet pipe/staff gage

Scale 1" = 1320'

RECEIVED

FEB 24 2015

WATER RESOURCES DEPT
 SALEM, OREGON

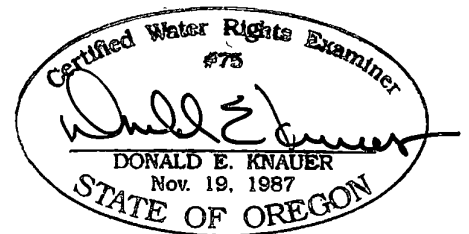

RENEWAL DATE: 6-30-2015

This map is not intended to provide legal dimensions or locations of property ownership lines.