


T5S R23E TL 2400
3 ponds Reservoir Permit R-13288
No Name Reservoir Permit R-13289
Lost Valley Rd. Pond #2 Permit R-14657

RECEIVED BY OWRD

JUL 01 2015

SALEM, OR

1 inch = 1,320 feet

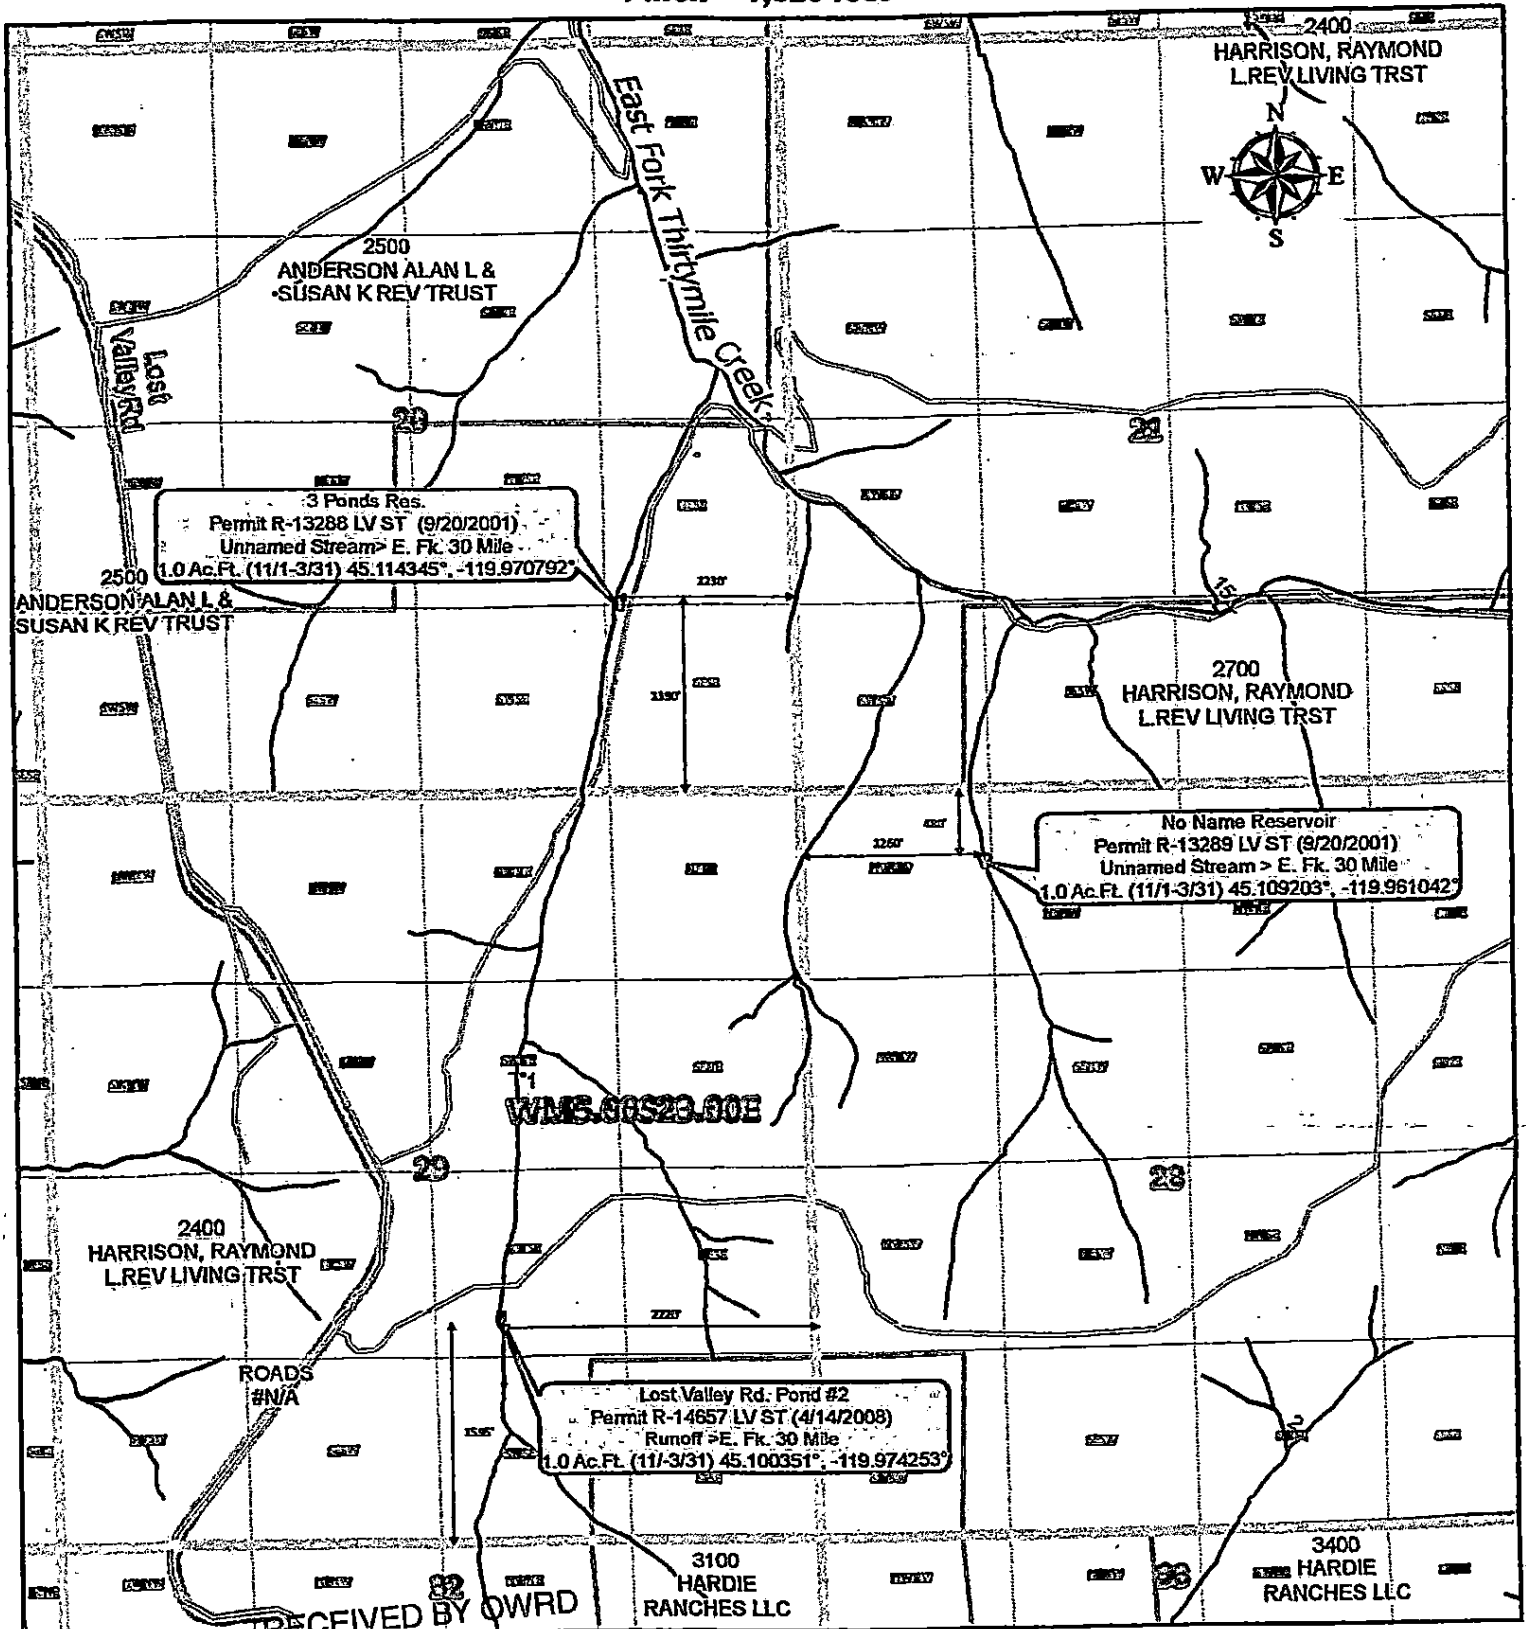

3 ponds Reservoir
 5.00S-23.00E-20-NE SE

JUL 16 2015

No Name Reservoir
 5.00S-23.00E-28-NW NW

Lost Valley Rd. Pond #2
 5.00S-23.00E-29-NW SE

SALEM, OR