



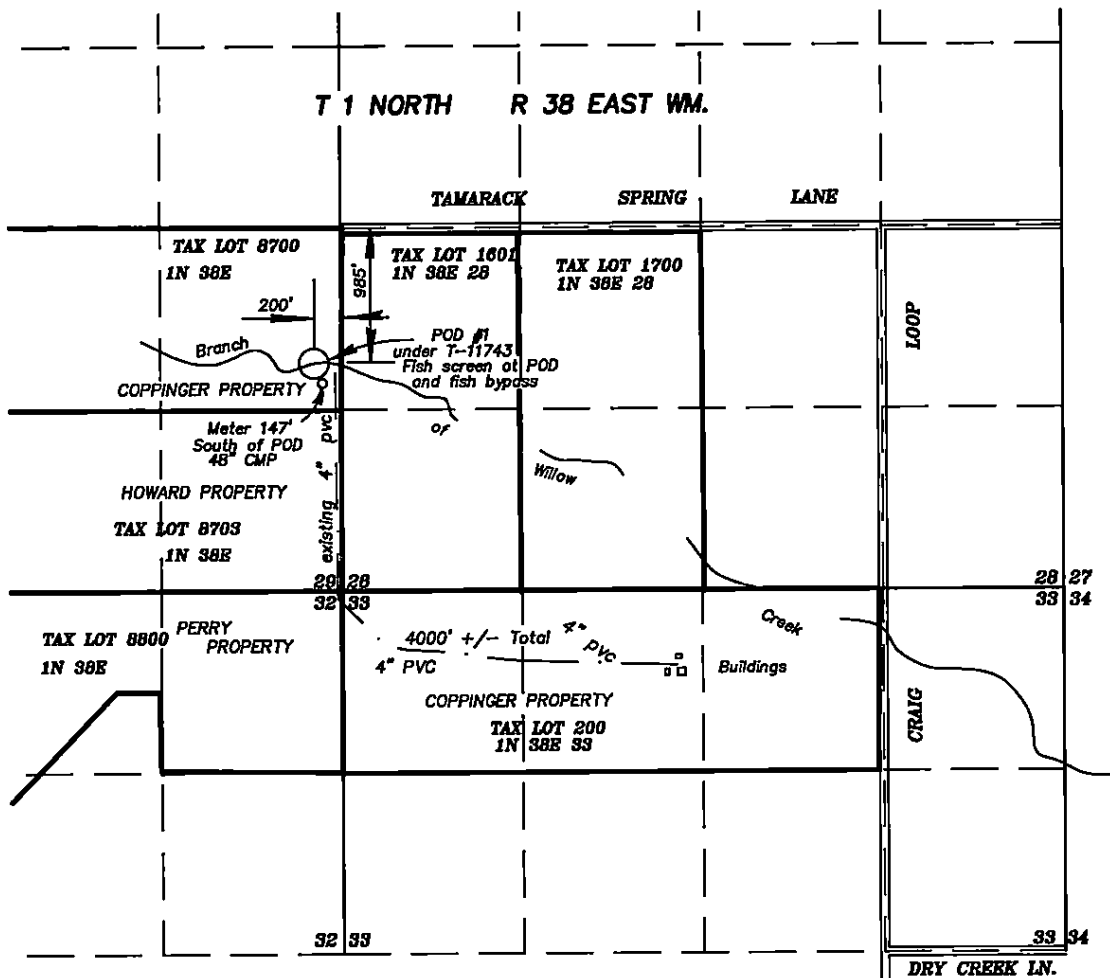

SCALE: 1"=1320'

NOTE: This right is for domestic purposes at the buildings shown on the above drawing.

POD #1
Lat: 45°32'01.72689"N
Lon: 118°04'40.20748"W

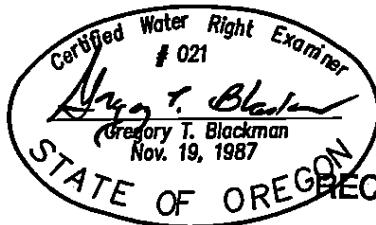

RECEIVED BY OWRD

JUL 22 2015

June 15, 2015
CLAIM OF BENEFICIAL USE MAP FOR
NEW POINT OF DIVERSION OF SURFACE WATER
UNDER CERTIFICATE T-11743

FOR
KENT AND DEANA COPPINGER

BY
GREG BLACKMAN WATER RIGHTS
126 RIDGE DRIVE
LA GRANDE, OREGON 97850

NOTE: The preparation of this map was for the purpose of identifying the location of the proposed water right and has no intent to provide dimensions or location of property ownership lines. Location information shown hereon was furnished by the applicant.

SALEM, OR

APPLICATION NO.

T-11743

PERMIT NUMBER