

Claim of Beneficial Use

APPLICATION S-84284

PERMIT S-53751

JOHN & TERRY HOLING

TOWNSHIP 26 S., RANGE 3 W., W.M. - SECTION 10



DOUGLAS COUNTY, OREGON

Assessor Map # T-26S, R3W-10C

POD-NESW, 2250 feet north and 30 feet west
from the south 1/4 corner section 10

Domestic Use
Year round use - NE/SW & NW/SE
Section 10

Base map - Douglas County GIS Tax Lots
adjusted to fit survey map CS-51/2712
over 4/2/2015 Oregon Map aerial photo
for assumed best fit

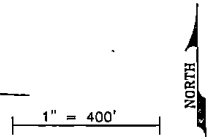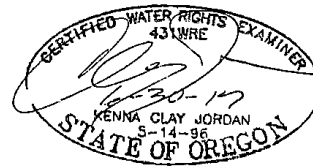

JORDAN ENGINEERING
460 JORDAN LANE
ROSEBURG, OREGON 97471
(541) 673-1931

This map is not intended to provide
legal dimensions or locations of
property ownership lines

06-03-2015 n.e.d.
revised 06-10-2015 n.e.d.

This map has been revised by WRD, per request from the CWRE. The Q/Q listed as the SE/SE, has been updated to SW/SE. mfb/wrd 9/18/18

MSR