
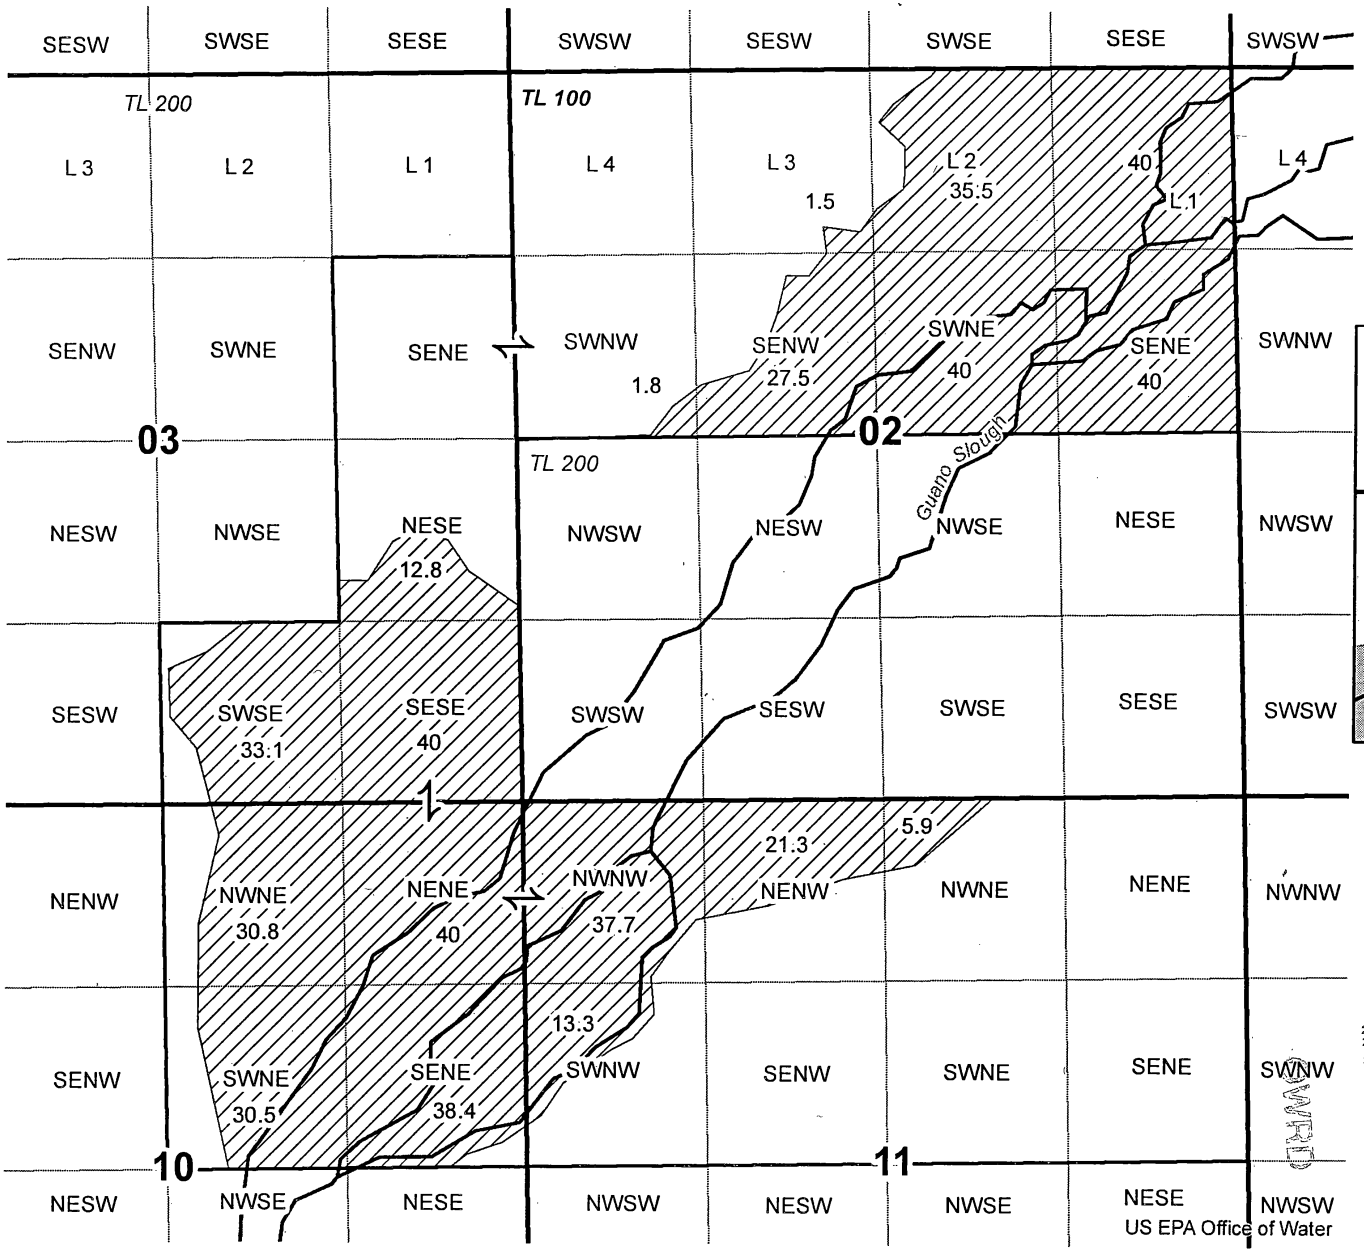


T35S, R29E WM

HARNEY COUNTY, OREGON

1 inch = 1,320 feet

0 660 1,320 Feet

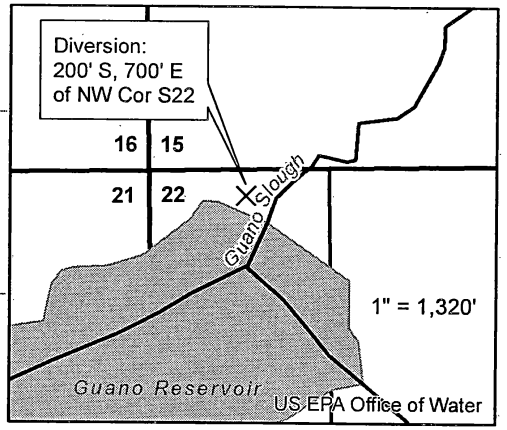

Tax Lots
Section
QQ

RECEIVED
MAR 19 2018
OWRD

Certified Water Right Examiner
033
Gary L. Delamatt
Nov. 19, 1987
STATE OF OREGON

RENEWAL DATE 12/31/2019

Claim of Beneficial Use Map

Rock Creek Ranch, Inc.

Date: 2/26/18 Ap S-59277 Permit S-44532 Job # 17070

NOTE: THIS MAP IS NOT INTENDED TO PROVIDE LEGAL DIMENSIONS OR LOCATIONS OF PROPERTY OWNERSHIP LINES.

WATER RIGHT SERVICES, LLC
PO BOX 1830, BEND, OR 97709
CCB# 197121 www.oregonwater.us
541-389-2837 JOHNSHORT@USA.COM