




TOWNSHIP 14 SOUTH, RANGE 12 EAST, W.M.

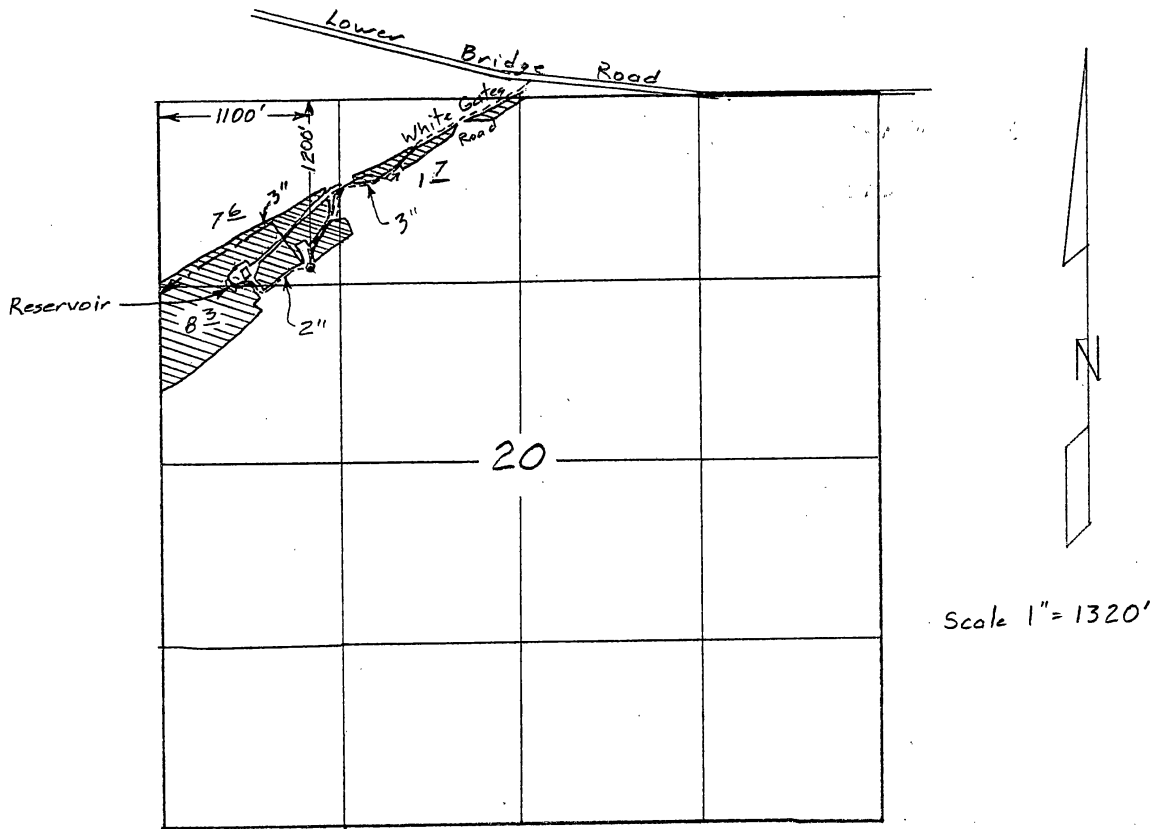

Surveyed June 21, 2002

Claim of Beneficial Use Map
for
EUGENE & JOYCE FALTUS

Application G-14356
Permit G-13248

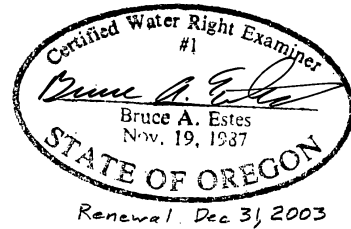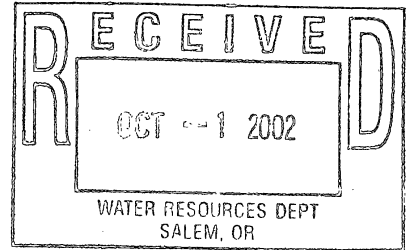

This map is for the purpose of locating a water right only and has no intent to provide legal dimensions or the location of property lines.

ESTES SURVEYS, LLC

PO Box 17519
Salem, OR 97305-7519
(503) 585-7593

60382 Arnold Rd
Bend, OR 97702
(541) 382-7391