


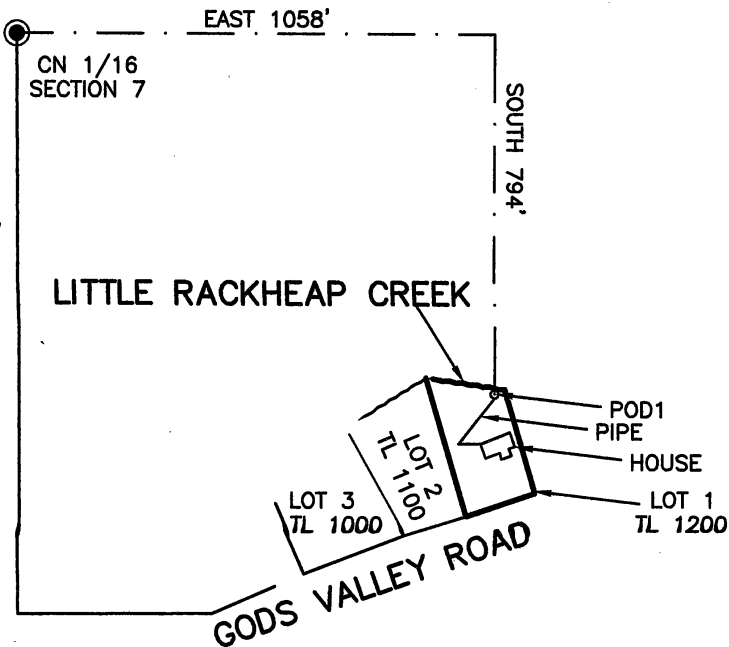

NOTES

THE PURPOSE OF THIS MAP IS TO SHOW WATER RIGHT LOCATION.

THIS MAP DOES NOT CONSTITUTE A BOUNDARY SURVEY.
THIS MAP IS NOT INTENDED TO PROVIDE LEGAL DIMENSIONS OF LOCATIONS OF PROPERTY OWNERSHIP LINES

THE WATER IS FOR DOMESTIC PURPOSES.

THE POINT OF DIVERSION (POD1) IS A PERFORATED CONCRETE TILE WELL LOCATED 794' SOUTH AND 1058' EAST OF THE CN 1/16 CORNER OF SECTION 7, THERE IS A METER SOUTH ± 10 OF THE WELL.


LEGEND

● CN 1/16 CORNER OF SECTION 7



N

SCALE:
1" = 400'

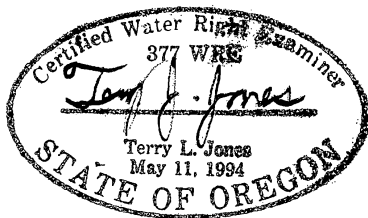

RECEIVED BY OWRD

MAY 28 2014

SALEM, OR

SITE\OLSONWR.DWG

RENEWAL DATE: JUNE 30 2015

APPLICATION #S-83734
PERMIT #S-53517

SURVEY BY:
BAYSIDE SURVEYING
11765 HWY 101 SOUTH
TILLAMOOK, OR. 97141
(503) 842-5551

FINAL PROOF MAP FOR:

WILLIAM & ILLA OLSON

APPLICATION #S-83734 PERMIT #S-53517

LOT 1, LITTLE RACKHEAP ACRES,

TAX LOT 1200

SW 1/4 NE 1/4 SEC. 7, T3N, R9W, W.M.

TILLAMOOK COUNTY, OREGON

DATE	EQUIPMENT	FIELD	DRAWN	CHECKED	JOB NO.
APRIL 24, 2014	TOPCON GPT-3003W TDS NOMAD	TLJ/DWE	DWE	TLJ	