

T20S, R22E  
SECTIONS 27, 34 & 35, WM

CROOK COUNTY, OREGON



0 1,320  
Feet

1" = 1,320'

RECEIVED BY OWNER

POU IR

1963

1971

June 21, 2000

September 25, 2000

Section

Quarter Quarter

Tax lot

Buried Pipeline

Road

Well & Meter


JUN 08 2017

SALEM, OR


WELL LOCATIONS:

F-5: 1,590' N, 2,750' W OF SE COR SEC 27

F-7: 1,740' N, 990' E OF SW COR SEC 26

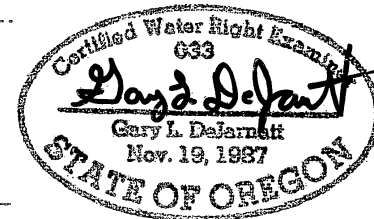

RENEWAL DATE 12/31/2017

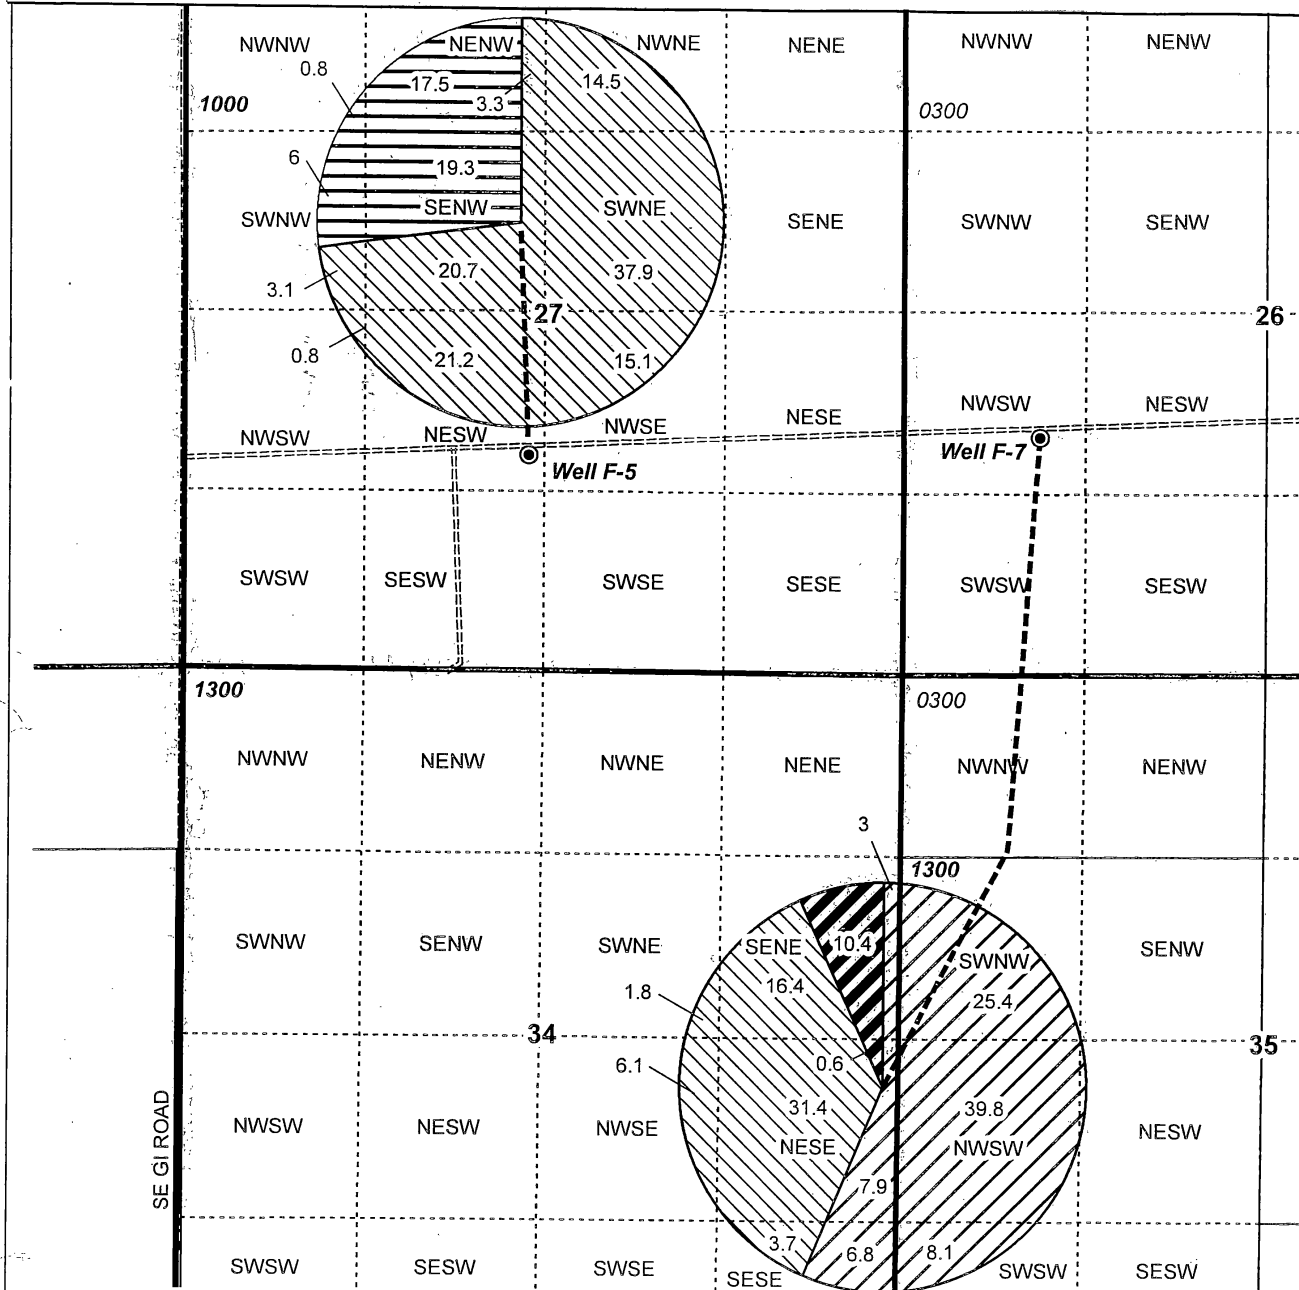

**CLAIM OF BENEFICIAL USE**  
Gi Ranch

T-12313

NOTE: THIS MAP IS NOT INTENDED TO  
PROVIDE LEGAL DIMENSIONS OR LOCATIONS  
OF PROPERTY OWNERSHIP LINES.

PROJECT #17005

MAY 27, 2017

**WATER RIGHT SERVICES, LLC**

PO BOX 1830, BEND, OR 97709

CCB# 197121 [www.oregonwater.us](http://www.oregonwater.us)

541-389-2837 [JOHNSHORT@USA.COM](mailto:JOHNSHORT@USA.COM)