

T20S, R22E
 SECTIONS 27, 34 & 35, WM

CROOK COUNTY, OREGON



0 1,320
 Feet

1" = 1,320'

RECEIVED BY OWNER

POU IR

1963

1971

June 21, 2000

September 25, 2000

Section

Quarter Quarter

Tax lot

Buried Pipeline

Road

Well & Meter


JUN 08 2017

SALEM, OR


WELL LOCATIONS:

F-5: 1,590' N, 2,750' W OF SE COR SEC 27

F-7: 1,740' N, 990' E OF SW COR SEC 26

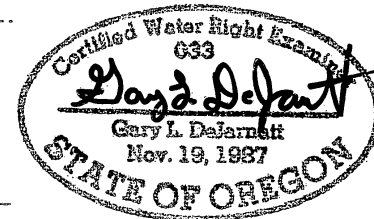

RENEWAL DATE 12/31/2017

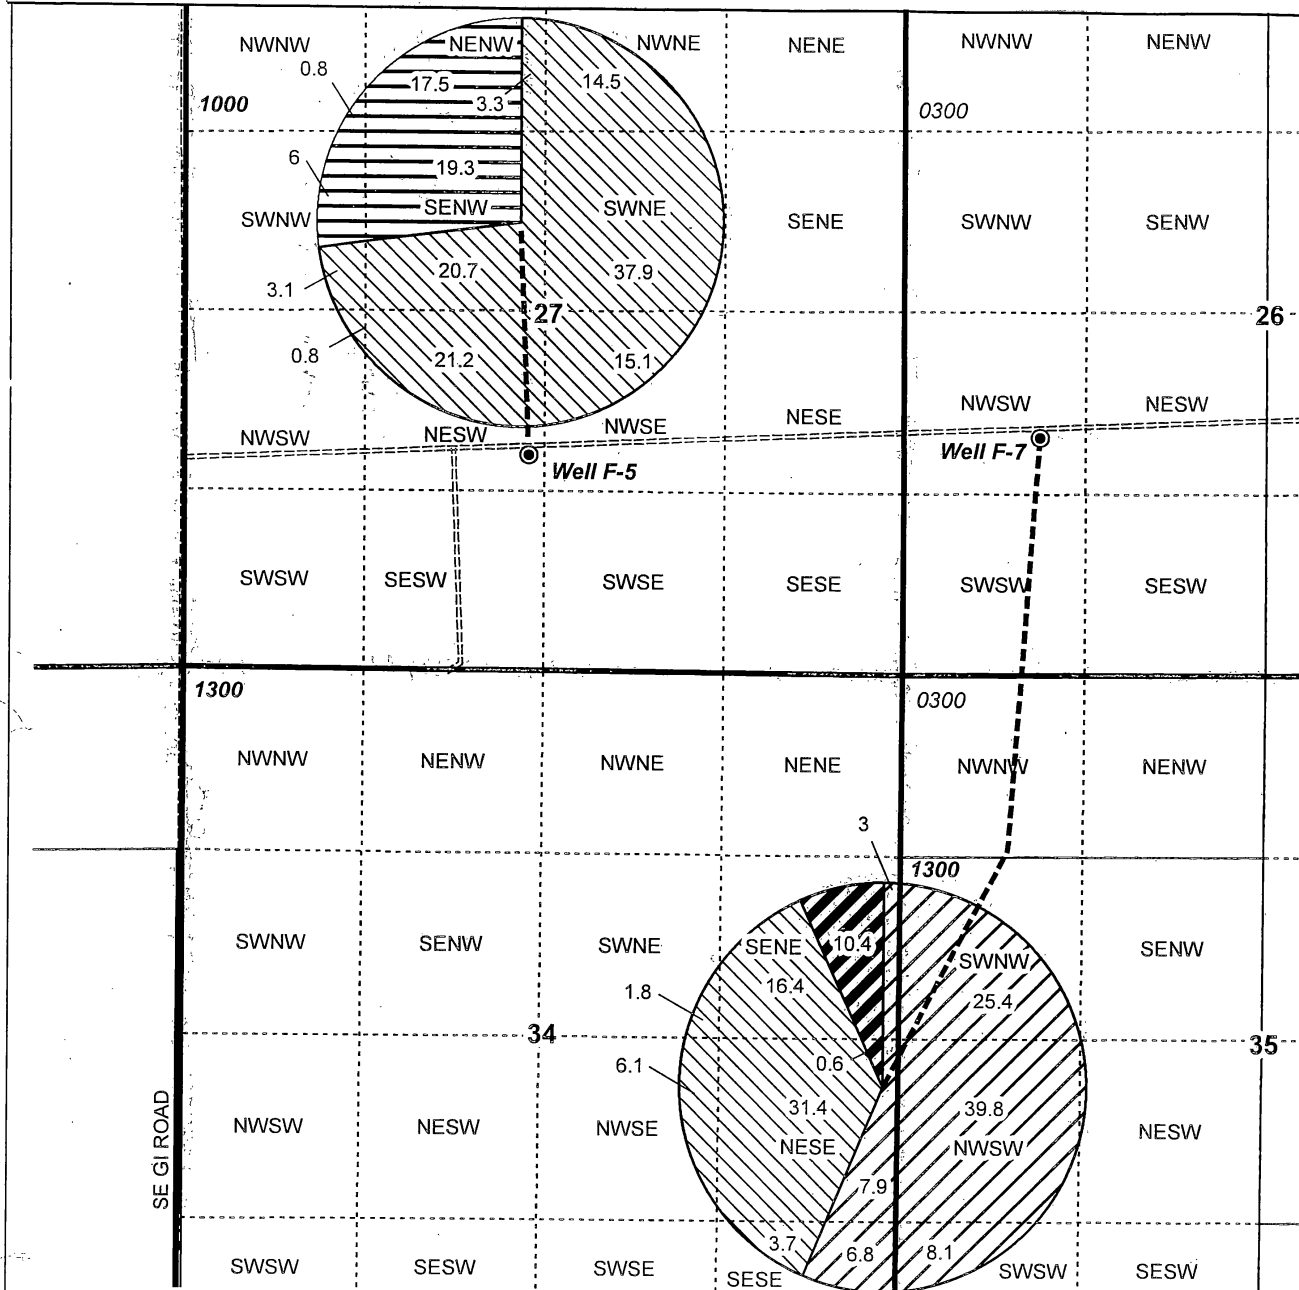

CLAIM OF BENEFICIAL USE
 GI Ranch

T-12313

NOTE: THIS MAP IS NOT INTENDED TO
 PROVIDE LEGAL DIMENSIONS OR LOCATIONS
 OF PROPERTY OWNERSHIP LINES.

PROJECT #17005

MAY 27, 2017

WATER RIGHT SERVICES, LLC

PO BOX 1830, BEND, OR 97709

CCB# 197121 www.oregonwater.us

541-389-2837 JOHNSHORT@USA.COM