



RECEIVED

JUN 27 2018

OWRD

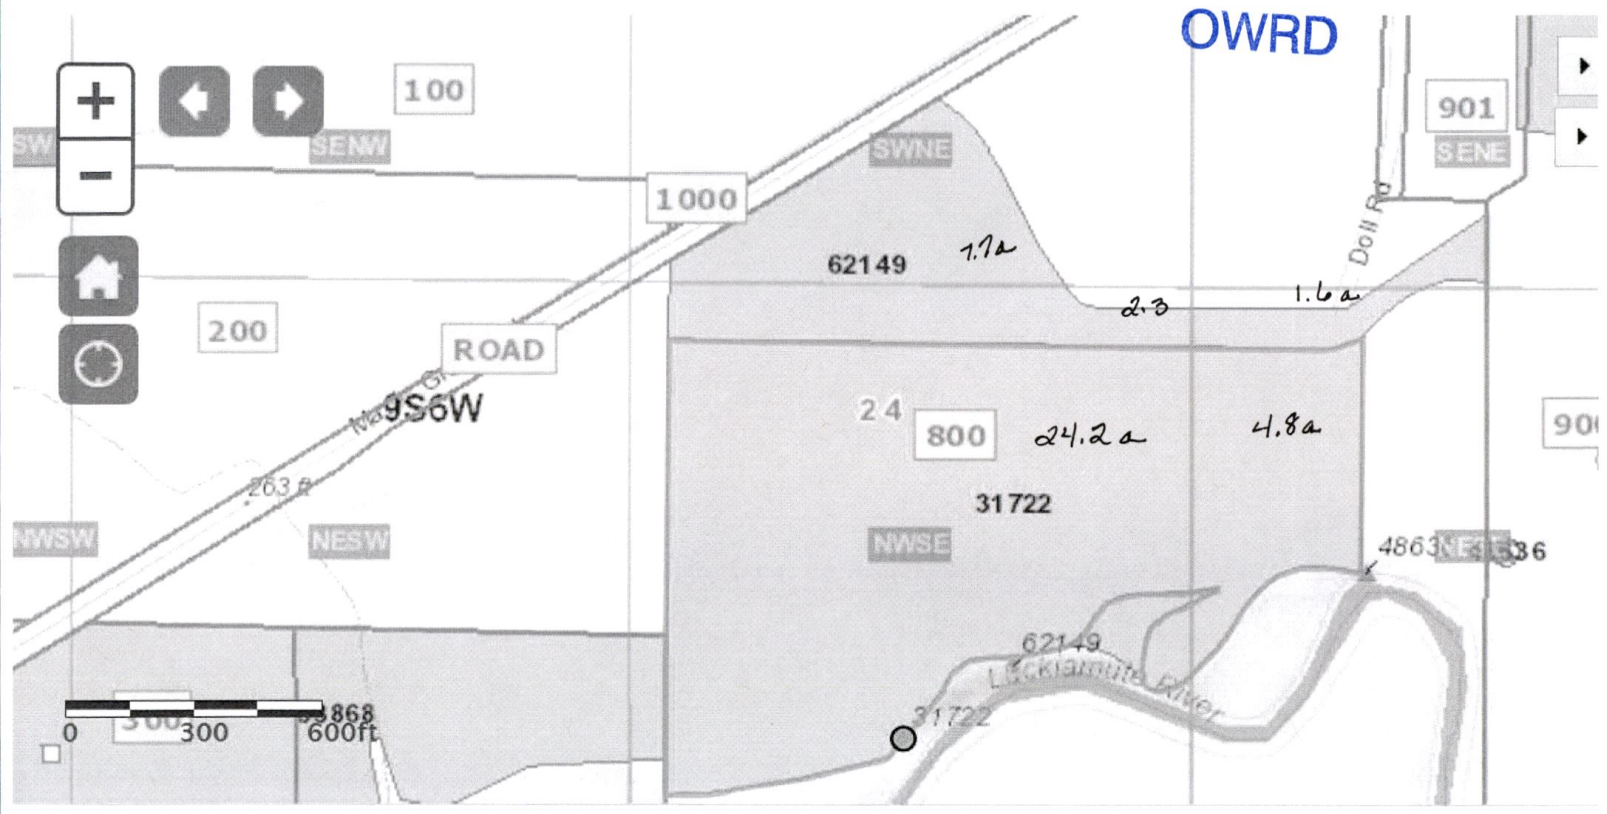

T.9S.R.6W.WM

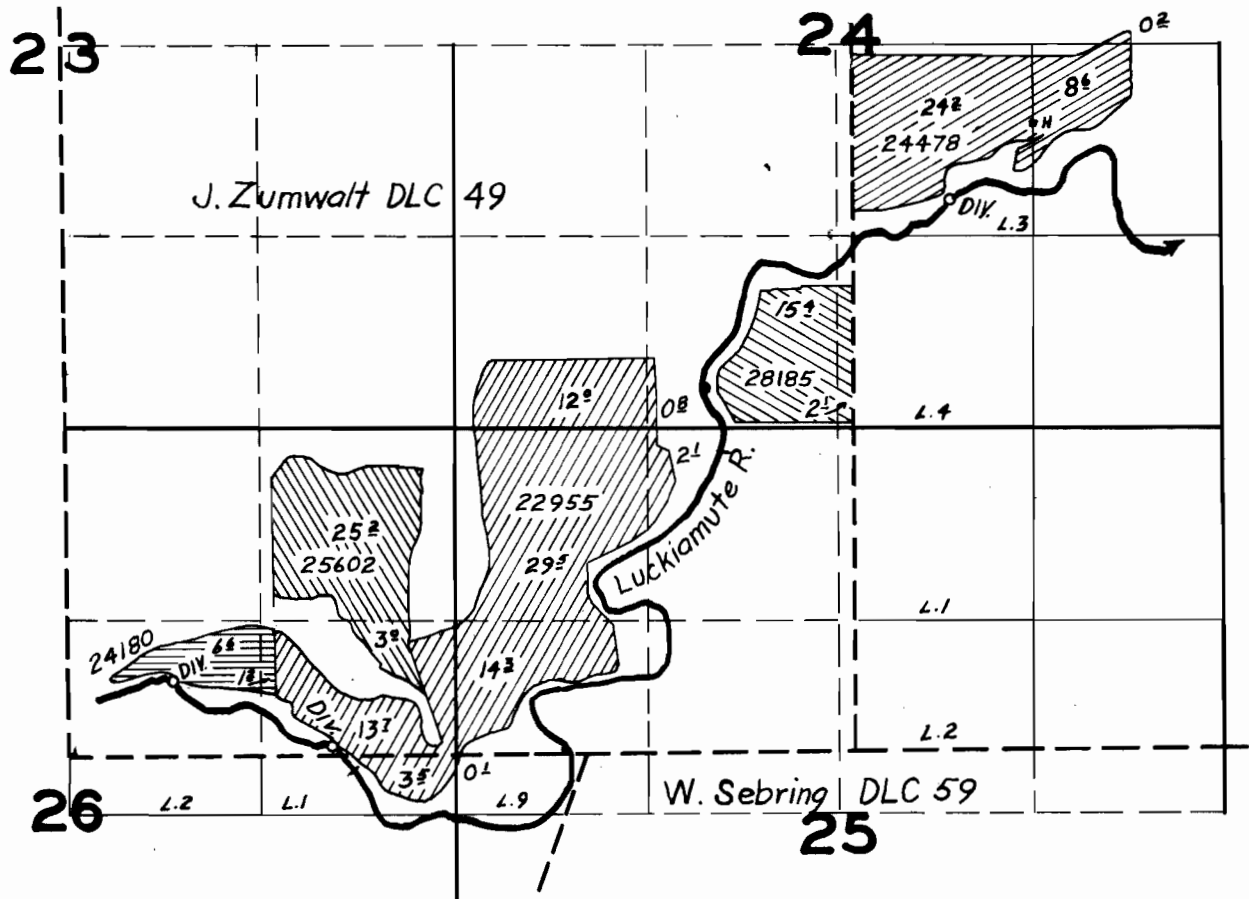

FINAL PROOF SURVEY

Application No.	24180	19015
	24478	19319
	25602	20039
	22955	18189
	28185	22641

IN NAME OF

Herman Amos, Kenneth F. Richards, E. M. Cates
 E. M. Cates, E. M. Cates

Surveyed July 13-14 1954, by T. Jones