


MAR 17 2003

WATER RESOURCES DEPT.  
SALEM, OREGON

1" = 400'

SEE MAP 35 37

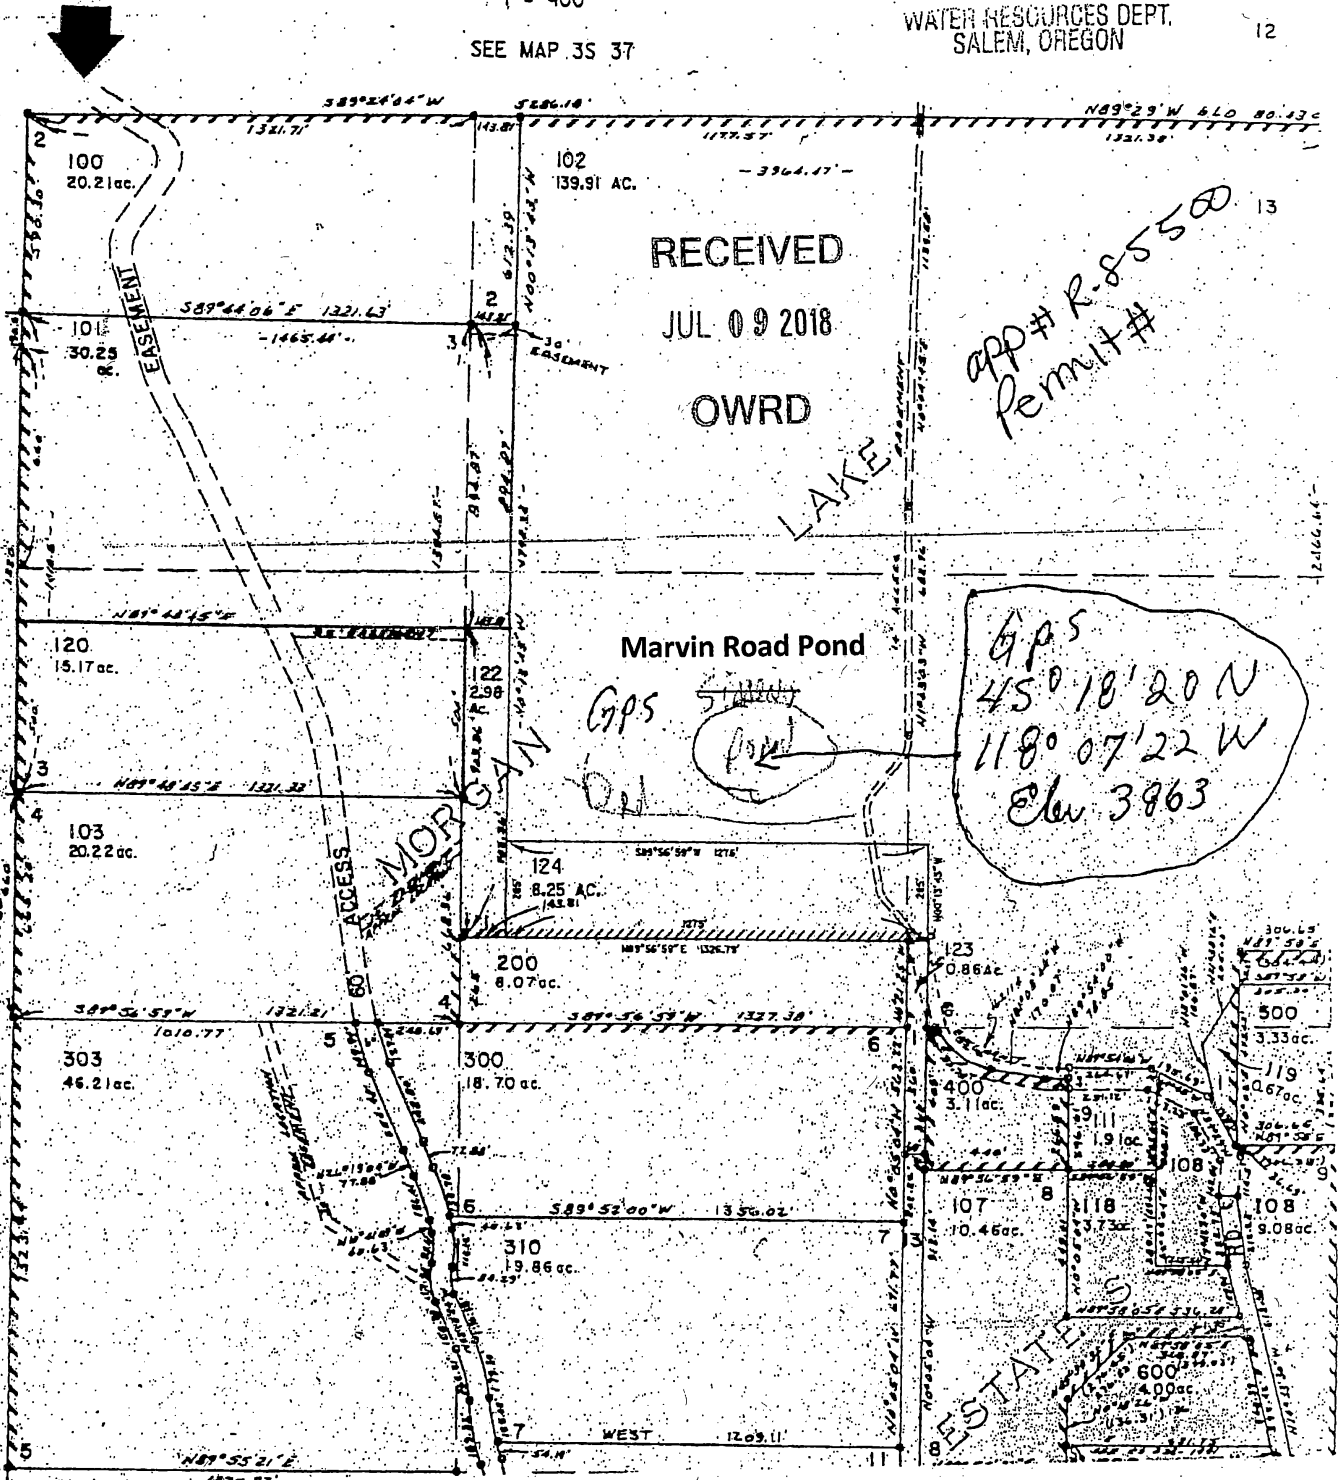

RECEIVED

JUL 09 2018

OWRD

APP # R-85500  
Permit #

Marvin Road Pond

GPS  
45° 18' 20" N  
118° 07' 22" W  

GPS ON  
START

app # R-85500  
Permit # R-13648

This map has been revised by WRD per request from the permit holder of record.  
The name of the pond has been updated to Marvin Road Pond. mfb/wrd 10/03/18

*MFB*  
wrd