
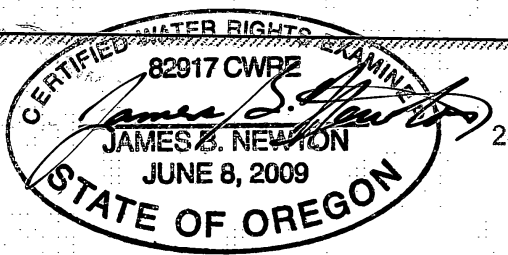


Claim of Beneficial Use Map

Tax Lot 1 0 6

Windy Lake - River Run Ranch

Located in NW-NE¼, NE-NE¼ and
the SE-NE¼ of Section 23,
T14S R14E W.M.
Crook County, Oregon

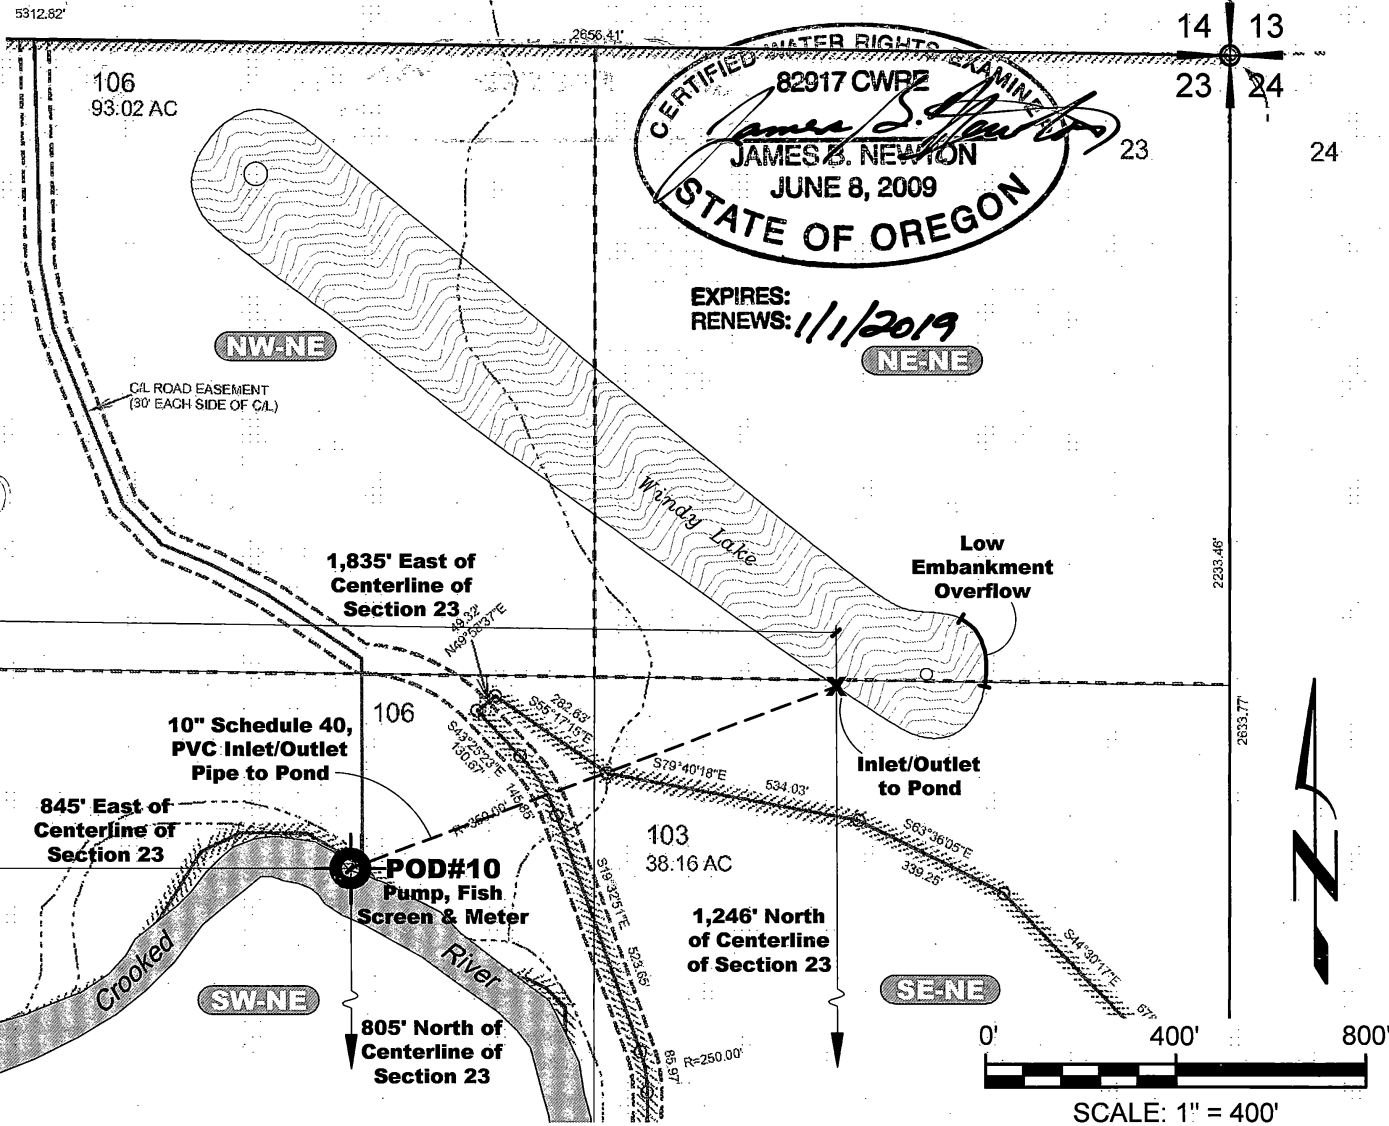

EXPIRES:
RENEWS: 11/1/2019
NE-NE

RECEIVED
JAN 02 2018
OWRD

NOTES

THIS MAP WAS PREPARED FOR THE PURPOSE OF IDENTIFYING THE LOCATION OF WATER RIGHTS ONLY AND IS NOT INTENDED TO PROVIDE LEGAL DIMENSIONS OR LOCATIONS OF PROPERTY OWNERSHIP LINES.



COBU Map - Permit R-14905
Windy Lake - River Run Ranch
Crook County, Oregon

DESIGNED BY: J. Newton	DRAWN BY: R2D	DATE: Dec 2017	PROJECT NO. CG-1006-101	FIGURE 1
---------------------------	------------------	-------------------	----------------------------	-------------

C:\Temp\CG\Projects\CG-1006 Wahlstrom\CG-1006-101_F1_Skillake_15:48_11/30/2017_SS