


SCALE: 1"=1320'

RECEIVED  
JUL 02 2018  
OWRD



Lands requesting primary water from existing well.

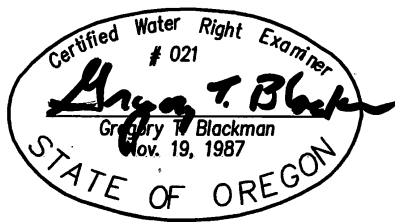

NOTE: The preparation of this map was for the purpose of identifying the location of the proposed water right and has no intent to provide dimensions or location of property ownership lines. Location information shown hereon was furnished by the applicant.

FINAL PROOF MAP OF  
WATER RIGHTS  
FOR  
H. L. WAGNER & SONS  
BY

BAGETT-GRIFFITH & BLACKMAN  
2006 ADAMS AVENUE  
LA GRANDE, OREGON 97850

DECEMBER 3, 1998  
REVISED JUNE 27, 2018

APPLICATION NO. G-14220

PERMIT NO. G-12873