

FINAL PROOF SURVEY


CHANGE IN POINT OF DIVERSION

UNDER: T-7788

IN NAME OF:
DOUGLAS S. JAMES

SURVEYED:
AUGUST 25, 1999 BY:

JONATHAN C. SPERO C.W.R.E. 123
1002 KINCAID RD./P.O. BOX 16
WILLIAMS. OREGON 97544
PH. (541) 846-6845

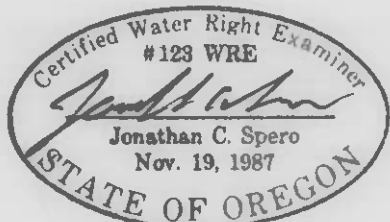


EXPIRES 06/30/ 2000

THIS MAP IS FOR THE PURPOSE OF IDENTIFYING THE LOCATION OF THE WATER RIGHT ONLY, AND IS NOT INTENDED TO PROVIDE LEGAL DIMENSIONS OR LOCATIONS OF PROPERTY OWNERSHIP LINES.

RECEIVED

EP 0 1999

WATER RESOURCES DEPT.
SALEM, OREGON

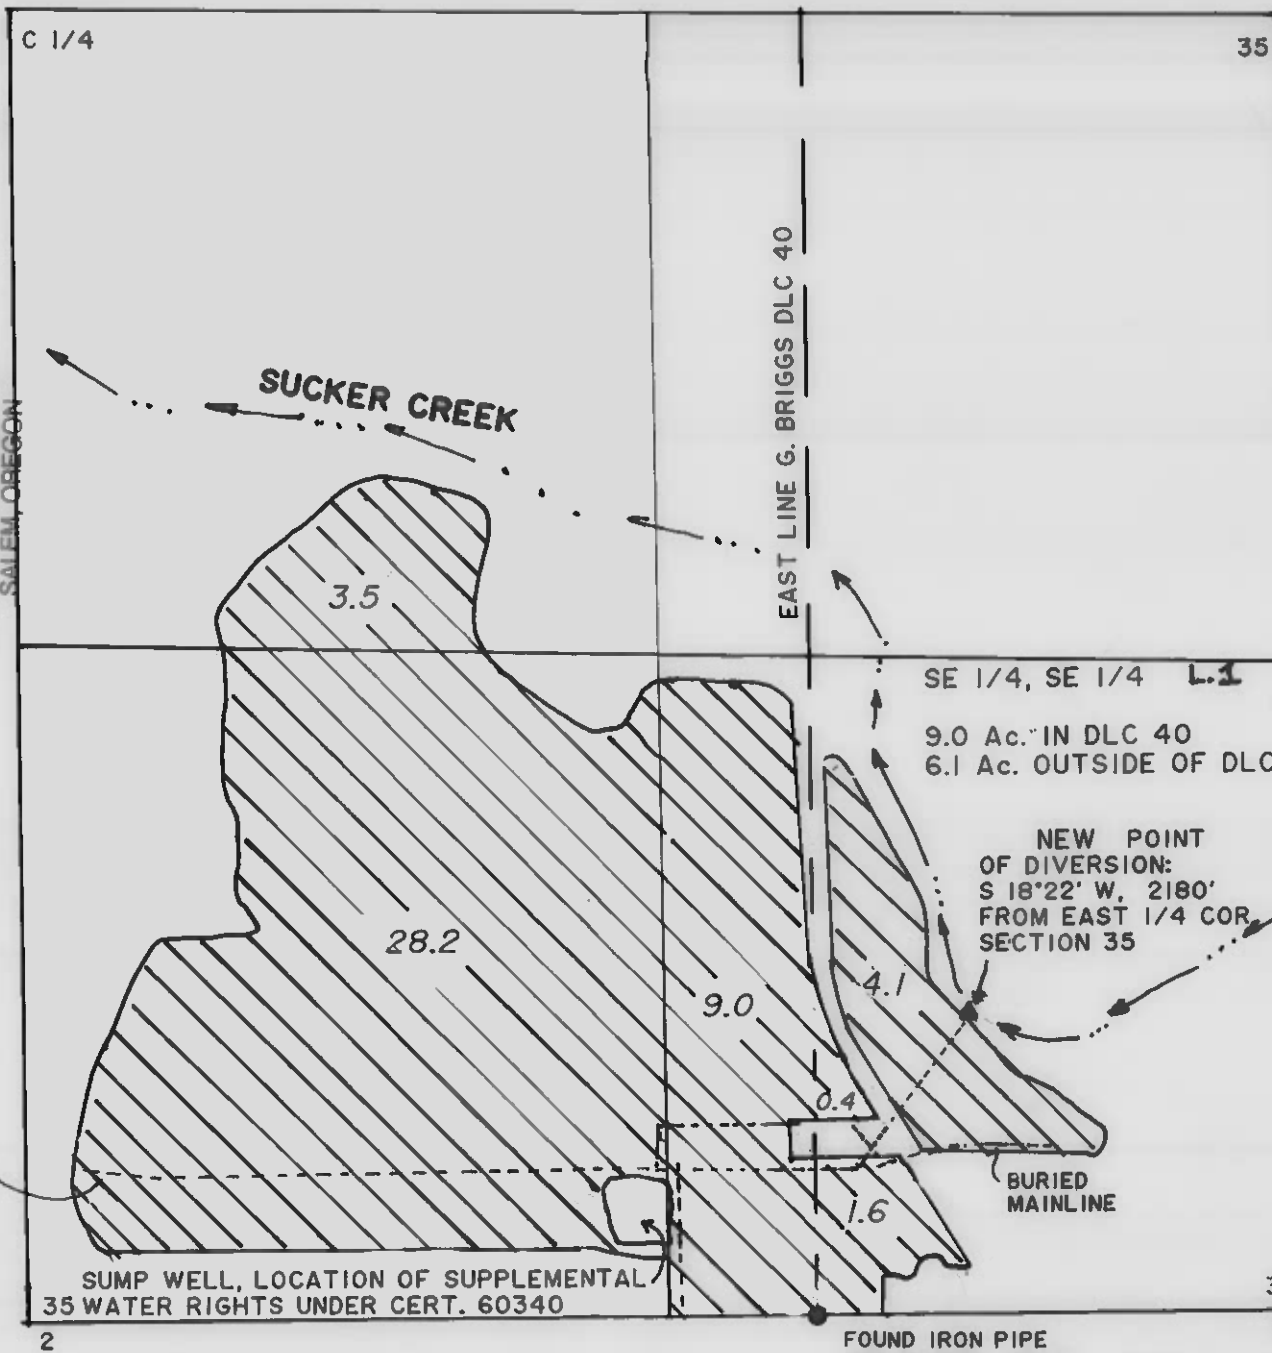

36
EAST 1/4 COR.
SECTION 35
FOUND IRON PIPE
WITH BRASS CAP PER
C.S. BK 8 P 388



SCALE: 1" = 400'

T.39 S. R.08 W.
SECTION 35 W.M.

35 36 SW CORNER
2 1 SECTION 36

FOUND IRON PIPE
PER SURVEY 115-53

Added Gov. lot #1 in SESE. J. Joye/WRD 3-28-16