


T8S R43E, Section 19, W.M.

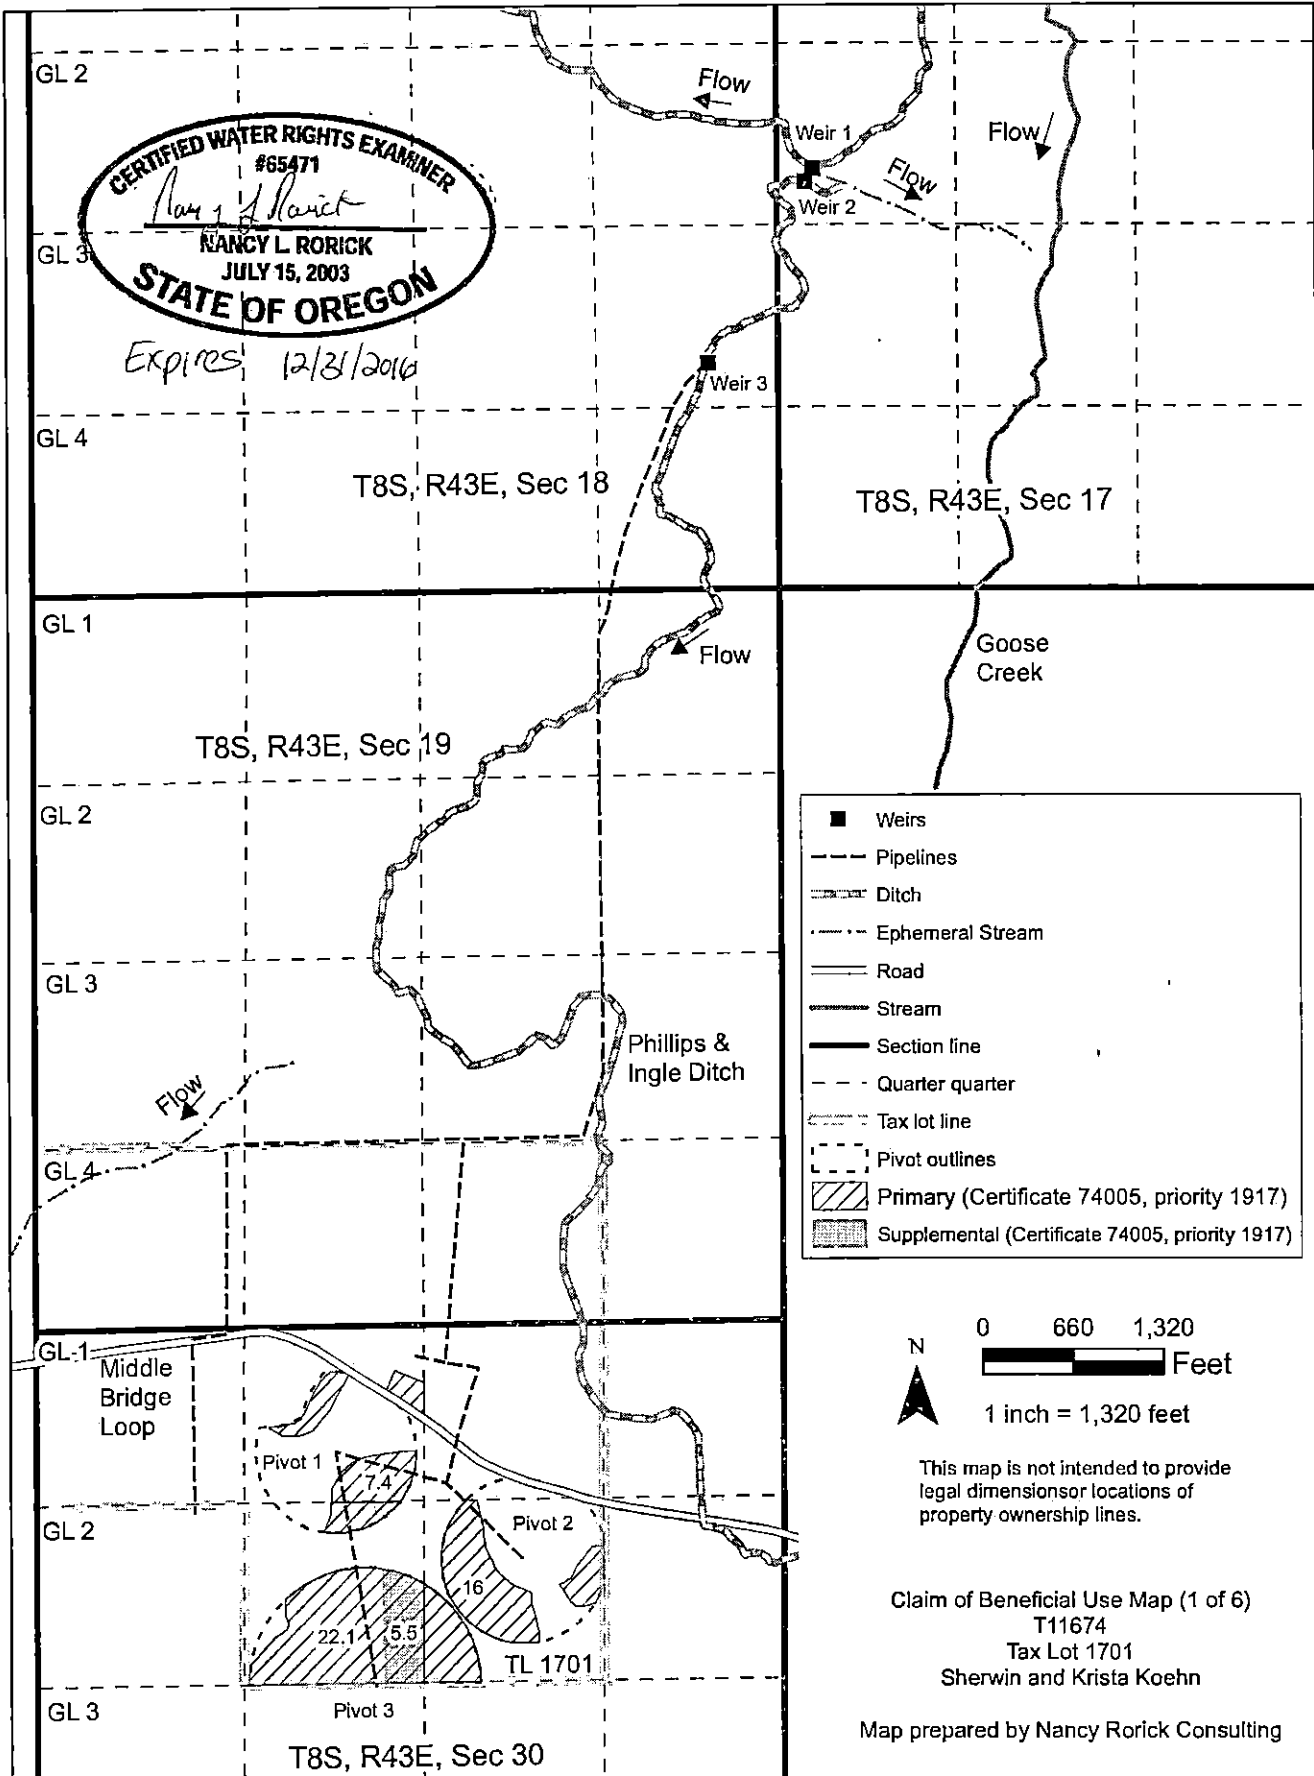

CERTIFIED WATER RIGHTS EXAMINER
 #65471
Nancy L. Rorick
NANCY L. RORICK
 JULY 15, 2003
STATE OF OREGON

Expires 12/31/2016

- Weirs
- - - Pipelines
- - - Ditch
- - - Ephemeral Stream
- Road
- Stream
- Section line
- - - Quarter quarter
- - - Tax lot line
- - - Pivot outlines
- ▨ Primary (Certificate 74005, priority 1917)
- ▩ Supplemental (Certificate 74005, priority 1917)


N
 0 660 1,320
 Feet
 1 inch = 1,320 feet

This map is not intended to provide legal dimensions or locations of property ownership lines.

Claim of Beneficial Use Map (1 of 6)
 T11674
 Tax Lot 1701
 Sherwin and Krista Koehn


Map prepared by Nancy Rorick Consulting

T5S, R43E, Sec. 21 and 22; W.M. (not surveyed)

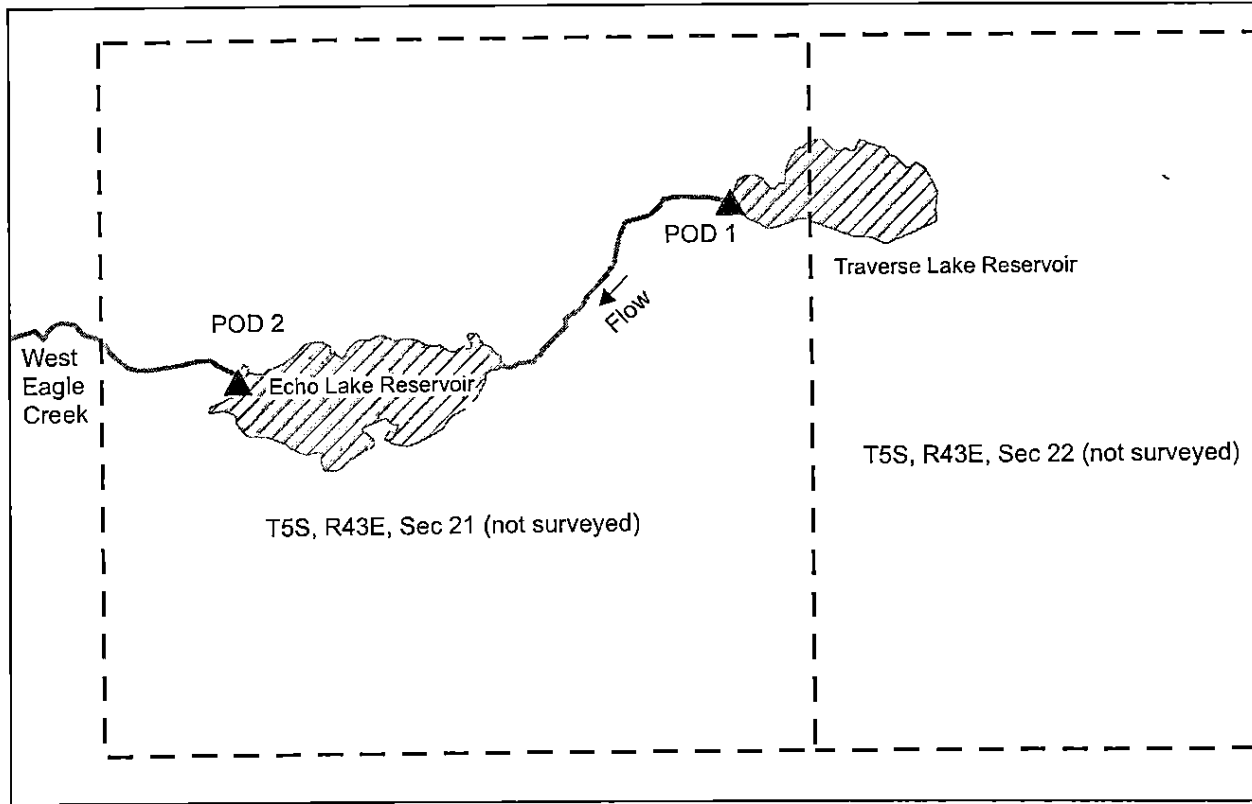

Expires 12/31/2016

- ▲ PODs
- Stream
- ▨ Reservoir
- - - Protracted section line (not surveyed)

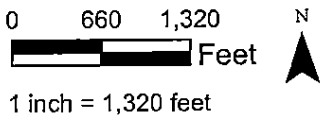

POD 1 – Traverse Lake Reservoir; Traverse Lake Reservoir is described in Certificate 7909 as located in Sections 15, 16, 21 and 22, T5S, R43E of the W.M. (T5S, R43E is unsurveyed, coordinates from Google Earth are 45.120635°/-117.442698°).

POD 2 – Echo Lake Reservoir; Echo Lake Reservoir is described in Certificate 7909 as located in Section 21, T5S, R43E, W.M. (T5S, R43E is unsurveyed, coordinates from Google Earth are 45.117041°/-117.456856°.)

Claim of Beneficial Use Map (4 of 6)

T11674



PODs 1 and 2

Sherwin and Krista Koehn


map prepared by Nancy Rorick Consulting

This map is not intended to provide legal dimensions or locations of property ownership lines.

T6S, R43E, Sec. 8 and T8S, R43E, Sec 4, W.M.

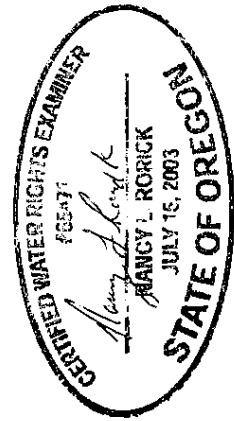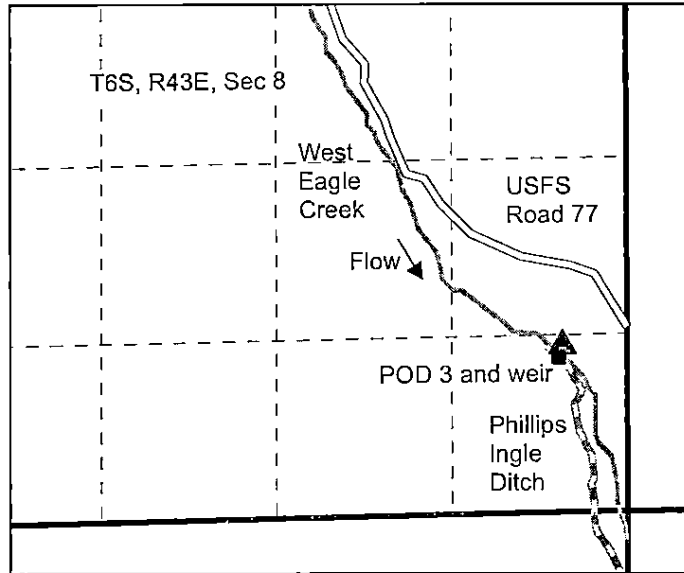


Expires 12/31/2016

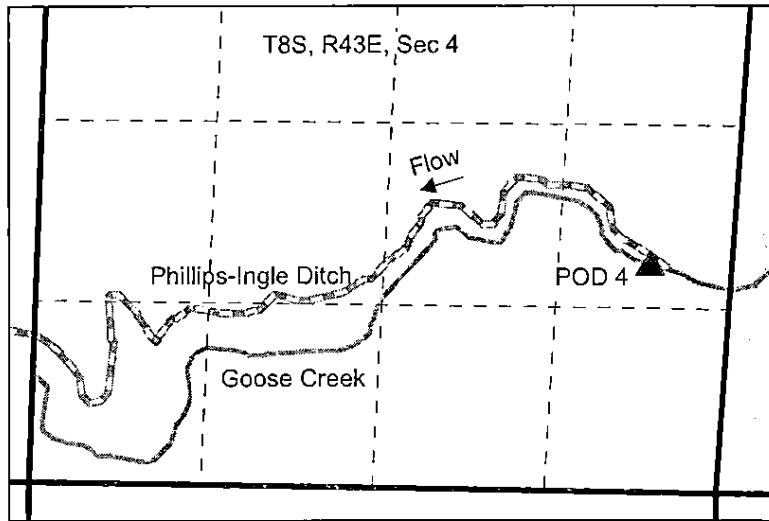

- Weir
- ▲ PODs
- Ditch
- Stream
- ▨ Reservoir
- Section line
- - - Quarter quarter

POD 3 – Phillips-Ingle Ditch from West Eagle Creek; T6S, R43E, SE SE of Section 8; 1,249 feet north and 477 feet west from the SE corner of Section 8.

POD 4 – Phillips-Ingle Ditch from Goose Creek; T8S, R43E, NE NE of Section 4; 1,703 feet north and 482 feet west from the SE corner of Section 4.

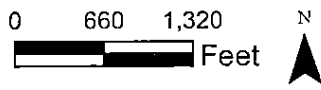

1 inch = 1,320 feet

This map is not intended to provide legal dimensions or locations of property ownership lines.

Claim of Beneficial Use Map (5 of 6)
 T11674
 PODs 3 and 4
 Sherwin and Krista Koehn
 map prepared by Nancy Rorick Consulting