


T8S R43E, Section 19, W.M.

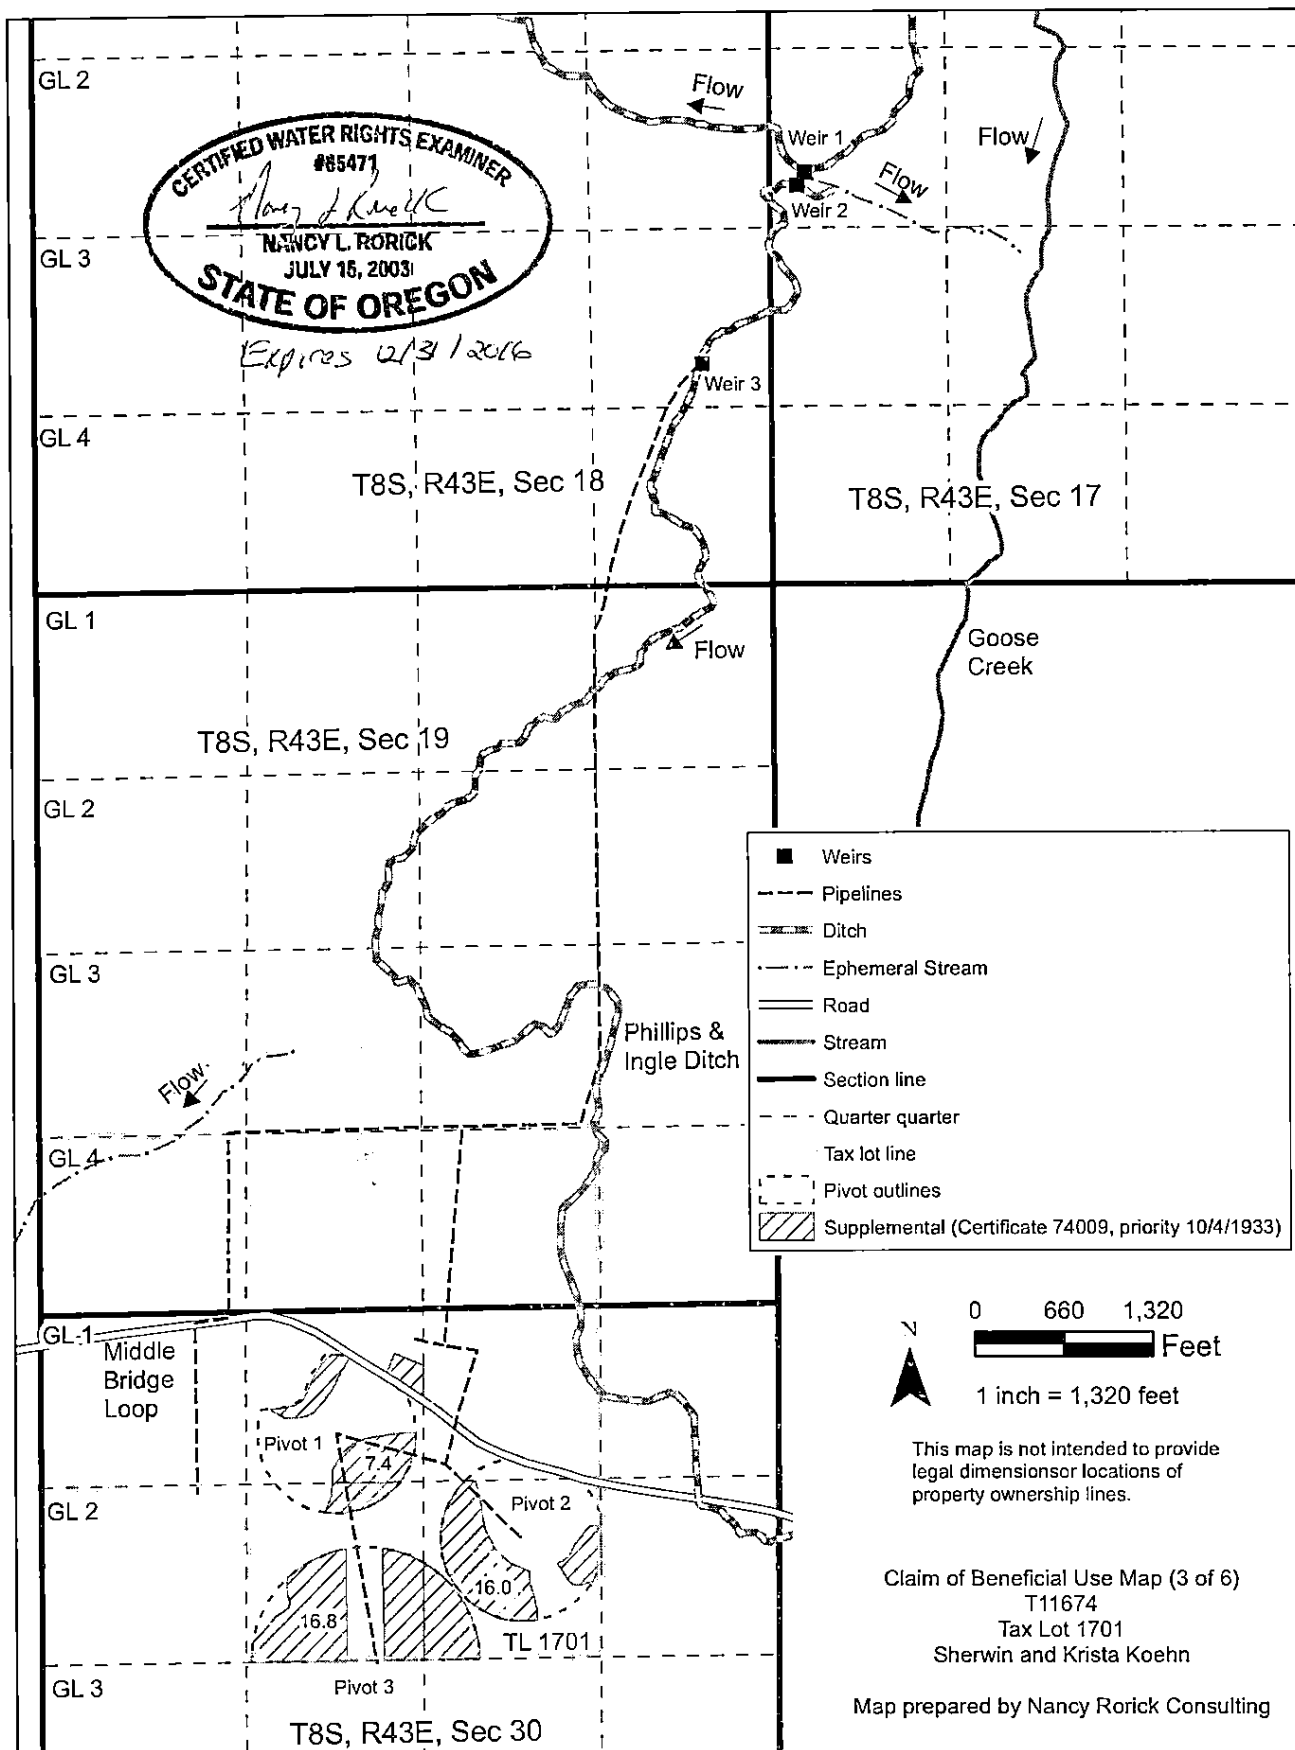

CERTIFIED WATER RIGHTS EXAMINER
 #85471
Nancy L. Rorick
NANCY L. RORICK
 JULY 16, 2003
STATE OF OREGON

- Weirs
- Pipelines
- Ditch
- Ephemeral Stream
- Road
- Stream
- Section line
- Quarter quarter
- Tax lot line
- Pivot outlines
- ▨ Supplemental (Certificate 74009, priority 10/4/1933)



0 660 1,320
 Feet
 1 inch = 1,320 feet

This map is not intended to provide legal dimensions or locations of property ownership lines.


Claim of Beneficial Use Map (3 of 6)
 T11674
 Tax Lot 1701
 Sherwin and Krista Koehn

Map prepared by Nancy Rorick Consulting

T6S, R43E, Sec. 8 and T8S, R43E, Sec 4, W.M.

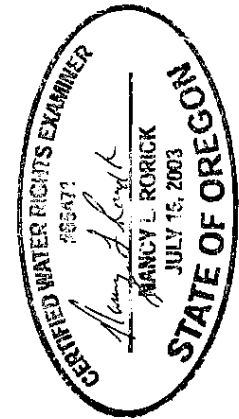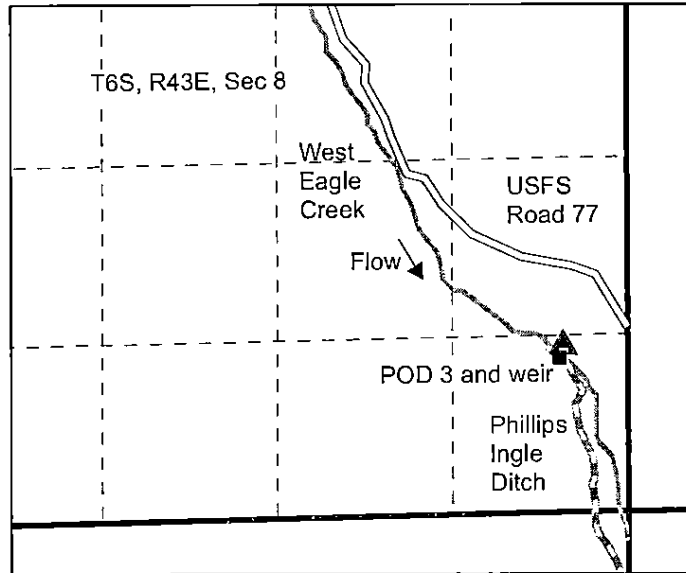


Expires 12/31/2016

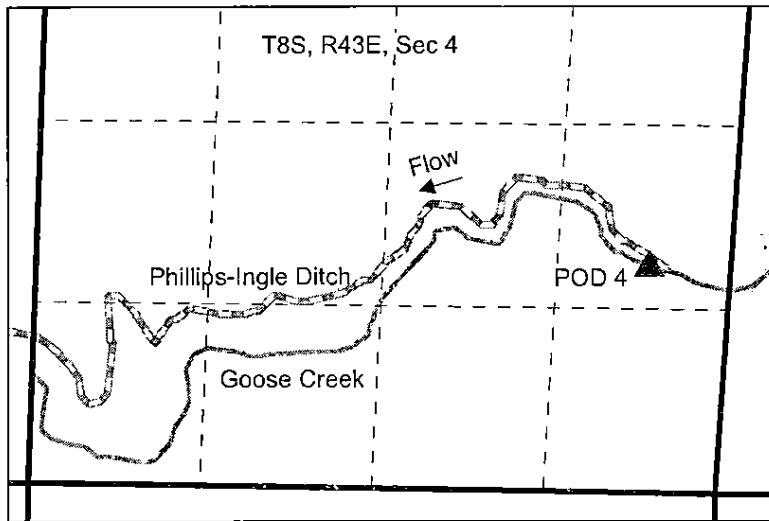

- Weir
- ▲ PODs
- Ditch
- Stream
- ▨ Reservoir
- Section line
- - - Quarter quarter

POD 3 – Phillips-Ingle Ditch from West Eagle Creek; T6S, R43E, SE SE of Section 8; 1,249 feet north and 477 feet west from the SE corner of Section 8.

POD 4 – Phillips-Ingle Ditch from Goose Creek; T8S, R43E, NE NE of Section 4; 1,703 feet north and 482 feet west from the SE corner of Section 4.

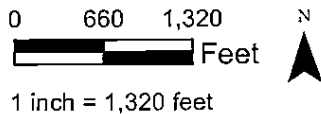

This map is not intended to provide legal dimensions or locations of property ownership lines.

Claim of Beneficial Use Map (5 of 6)
 T11674
 PODs 3 and 4
 Sherwin and Krista Koehn
 map prepared by Nancy Rorick Consulting