RECEIVED

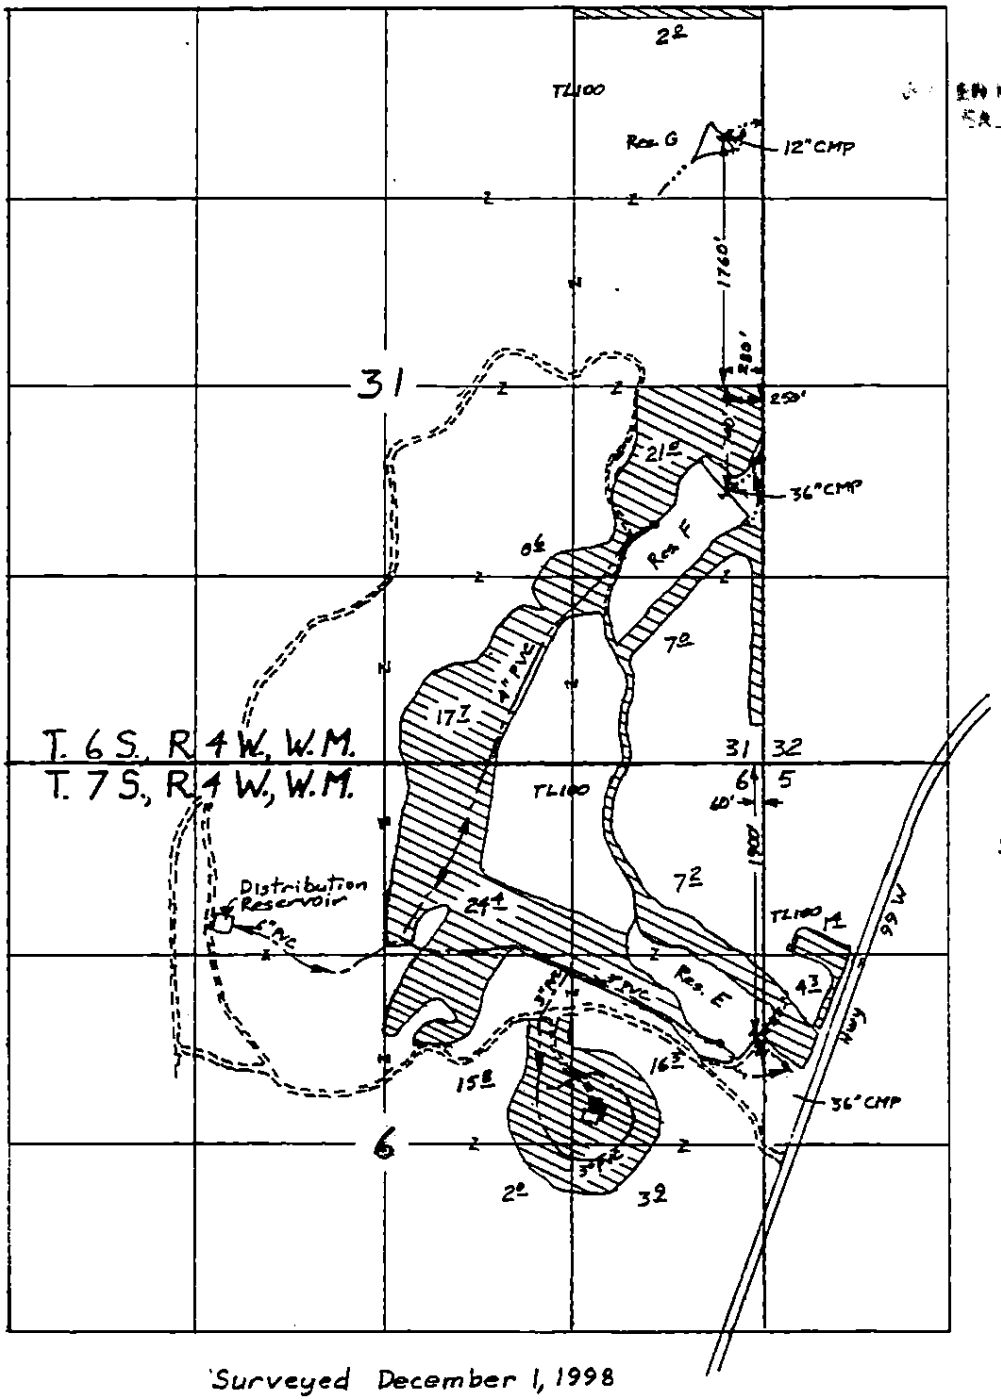

Scale 1"=1320'

Surveyed December 1, 1998

App R-72658, Per R-11498 & App. 72659, Per 51534

Claim of Beneficial Use Map
for
CONRAD H. KONING

Certified Water Right Examiner #1
Bruce A. Estes
Nov. 19, 1987
STATE OF OREGON

This map is for the purpose of locating a water right only and has no intent to provide legal dimensions or the location of property lines.

ESTES SURVEYS
6293 Sunnyview Rd. NE
Salem, OR 97305
(503) 585-7593
60382 Arnold Rd.
Bend, OR 97702
(503) 382-7391