

JOSEPH P AND JERI D McELIGOTT
COBU MAP
FOR APPLICATION R-74292, PERMIT 14151
T5S, R26E, W.M., MORROW COUNTY


LOCATION OF RESERVOIRS

- R-1 760' N & 680' W FROM THE E1/4 CORNER OF SEC 9
- R-2 225' S & 840' W FROM THE N1/4 CORNER OF SEC 9
- R-3 340' S & 785' W FROM THE N1/4 CORNER OF SEC 16
- R-4 960' N & 560' W FROM THE SE CORNER OF SEC 16
- R-5 785' N & 40' E FROM THE SW CORNER OF SEC 14
- R-6 1405' N & 1730' E FROM THE SW CORNER OF SEC 15
- R-7 640' S & 200' E FROM THE NW CORNER OF SEC 22
- R-8 1560' S & 130' W FROM THE N1/4 CORNER OF SEC 21
- R-9 450' N & 50' E FROM THE SW CORNER OF SEC 17
- R-10 250' S & 1340' E FROM THE NW CORNER OF SEC 21



LEGEND

- R-7 RESERVOIR LOCATION AND DESIGNATION
- BOTTOM OF DRAINAGE BASIN, DRAINAGE IS TO THE NORTH

NOTE:
THE PURPOSE OF THIS MAP IS TO IDENTIFY THE APPROXIMATE LOCATION OF THE WATER RIGHT. IT IS NOT INTENDED TO PROVIDE INFORMATION RELATIVE TO THE LOCATION OF PROPERTY OWNERSHIP BOUNDARY LINES.

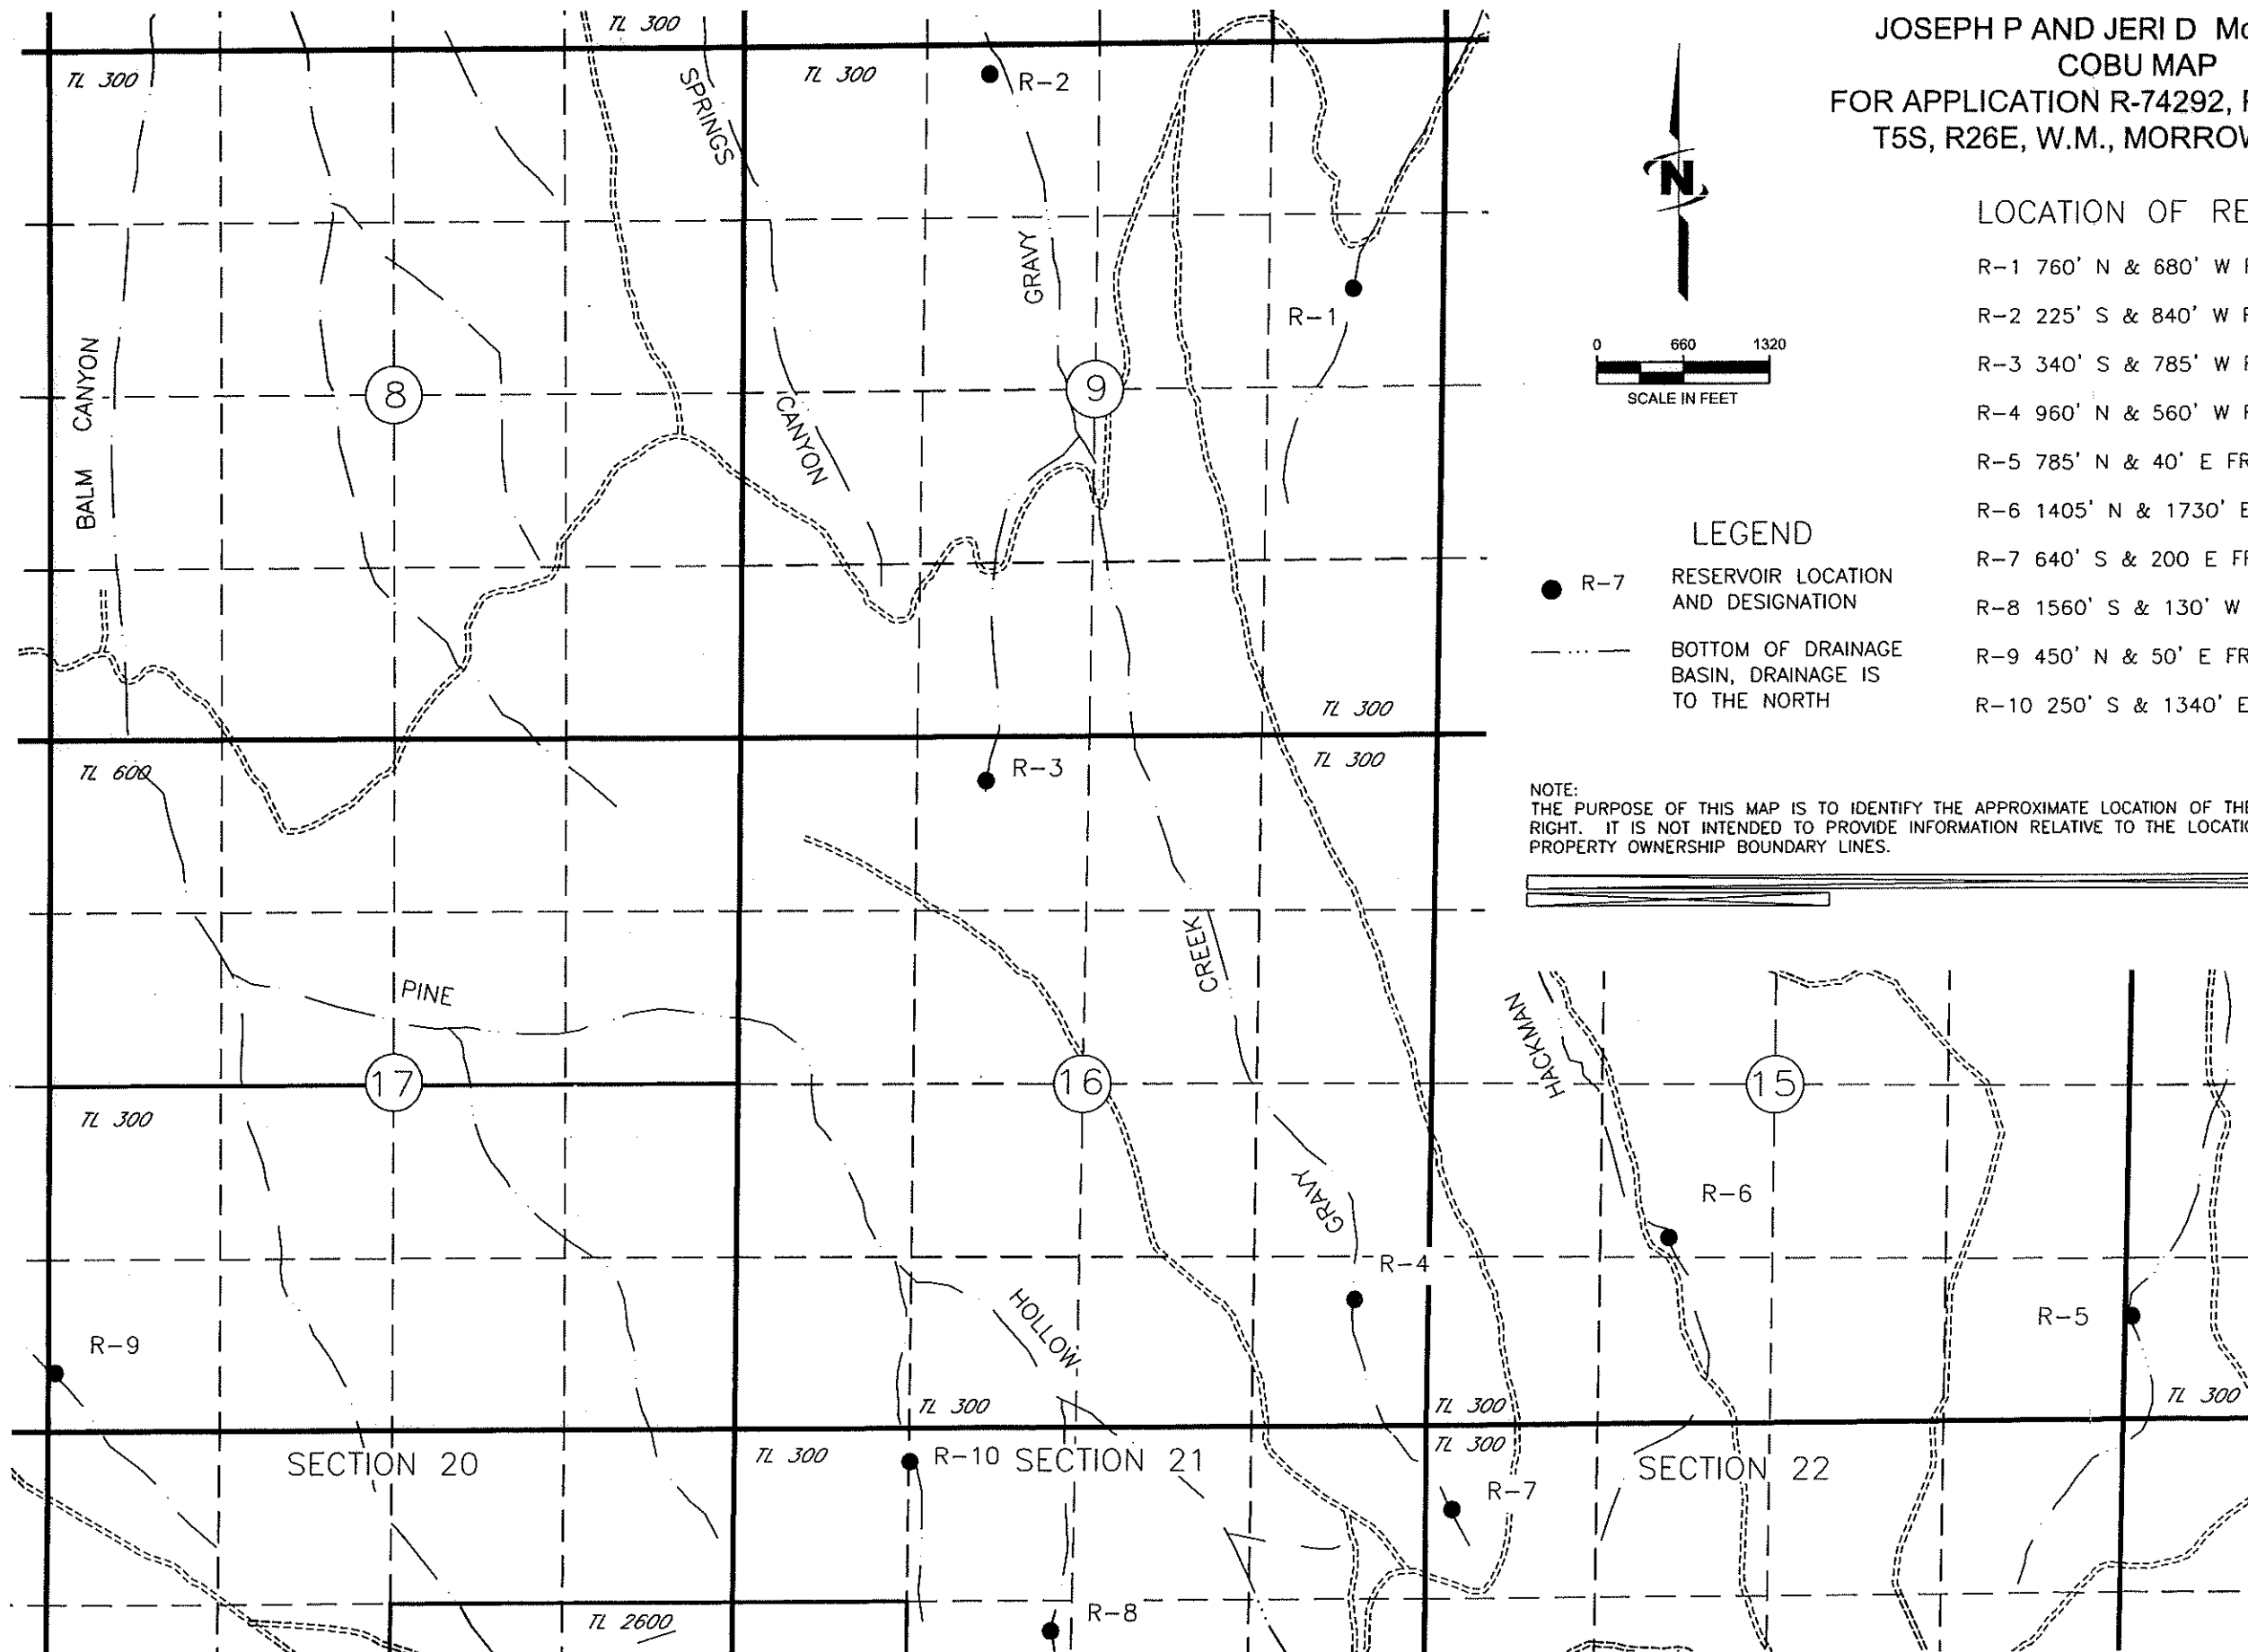

SECTION 14

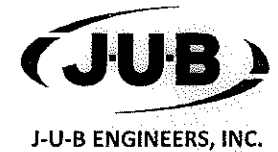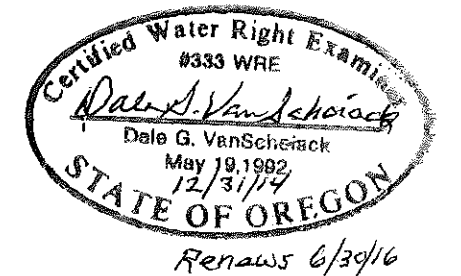

COBU MAP 888