


RECEIVED BY OWRC

2014

SALEM, OR

JOSEPH P AND JERI D McELLIGOTT
COBU MAP
FOR APPLICATION R-74211, PERMIT 14150
T5S, R26E, W.M., MORROW COUNTY

885
COBU MAP #
885

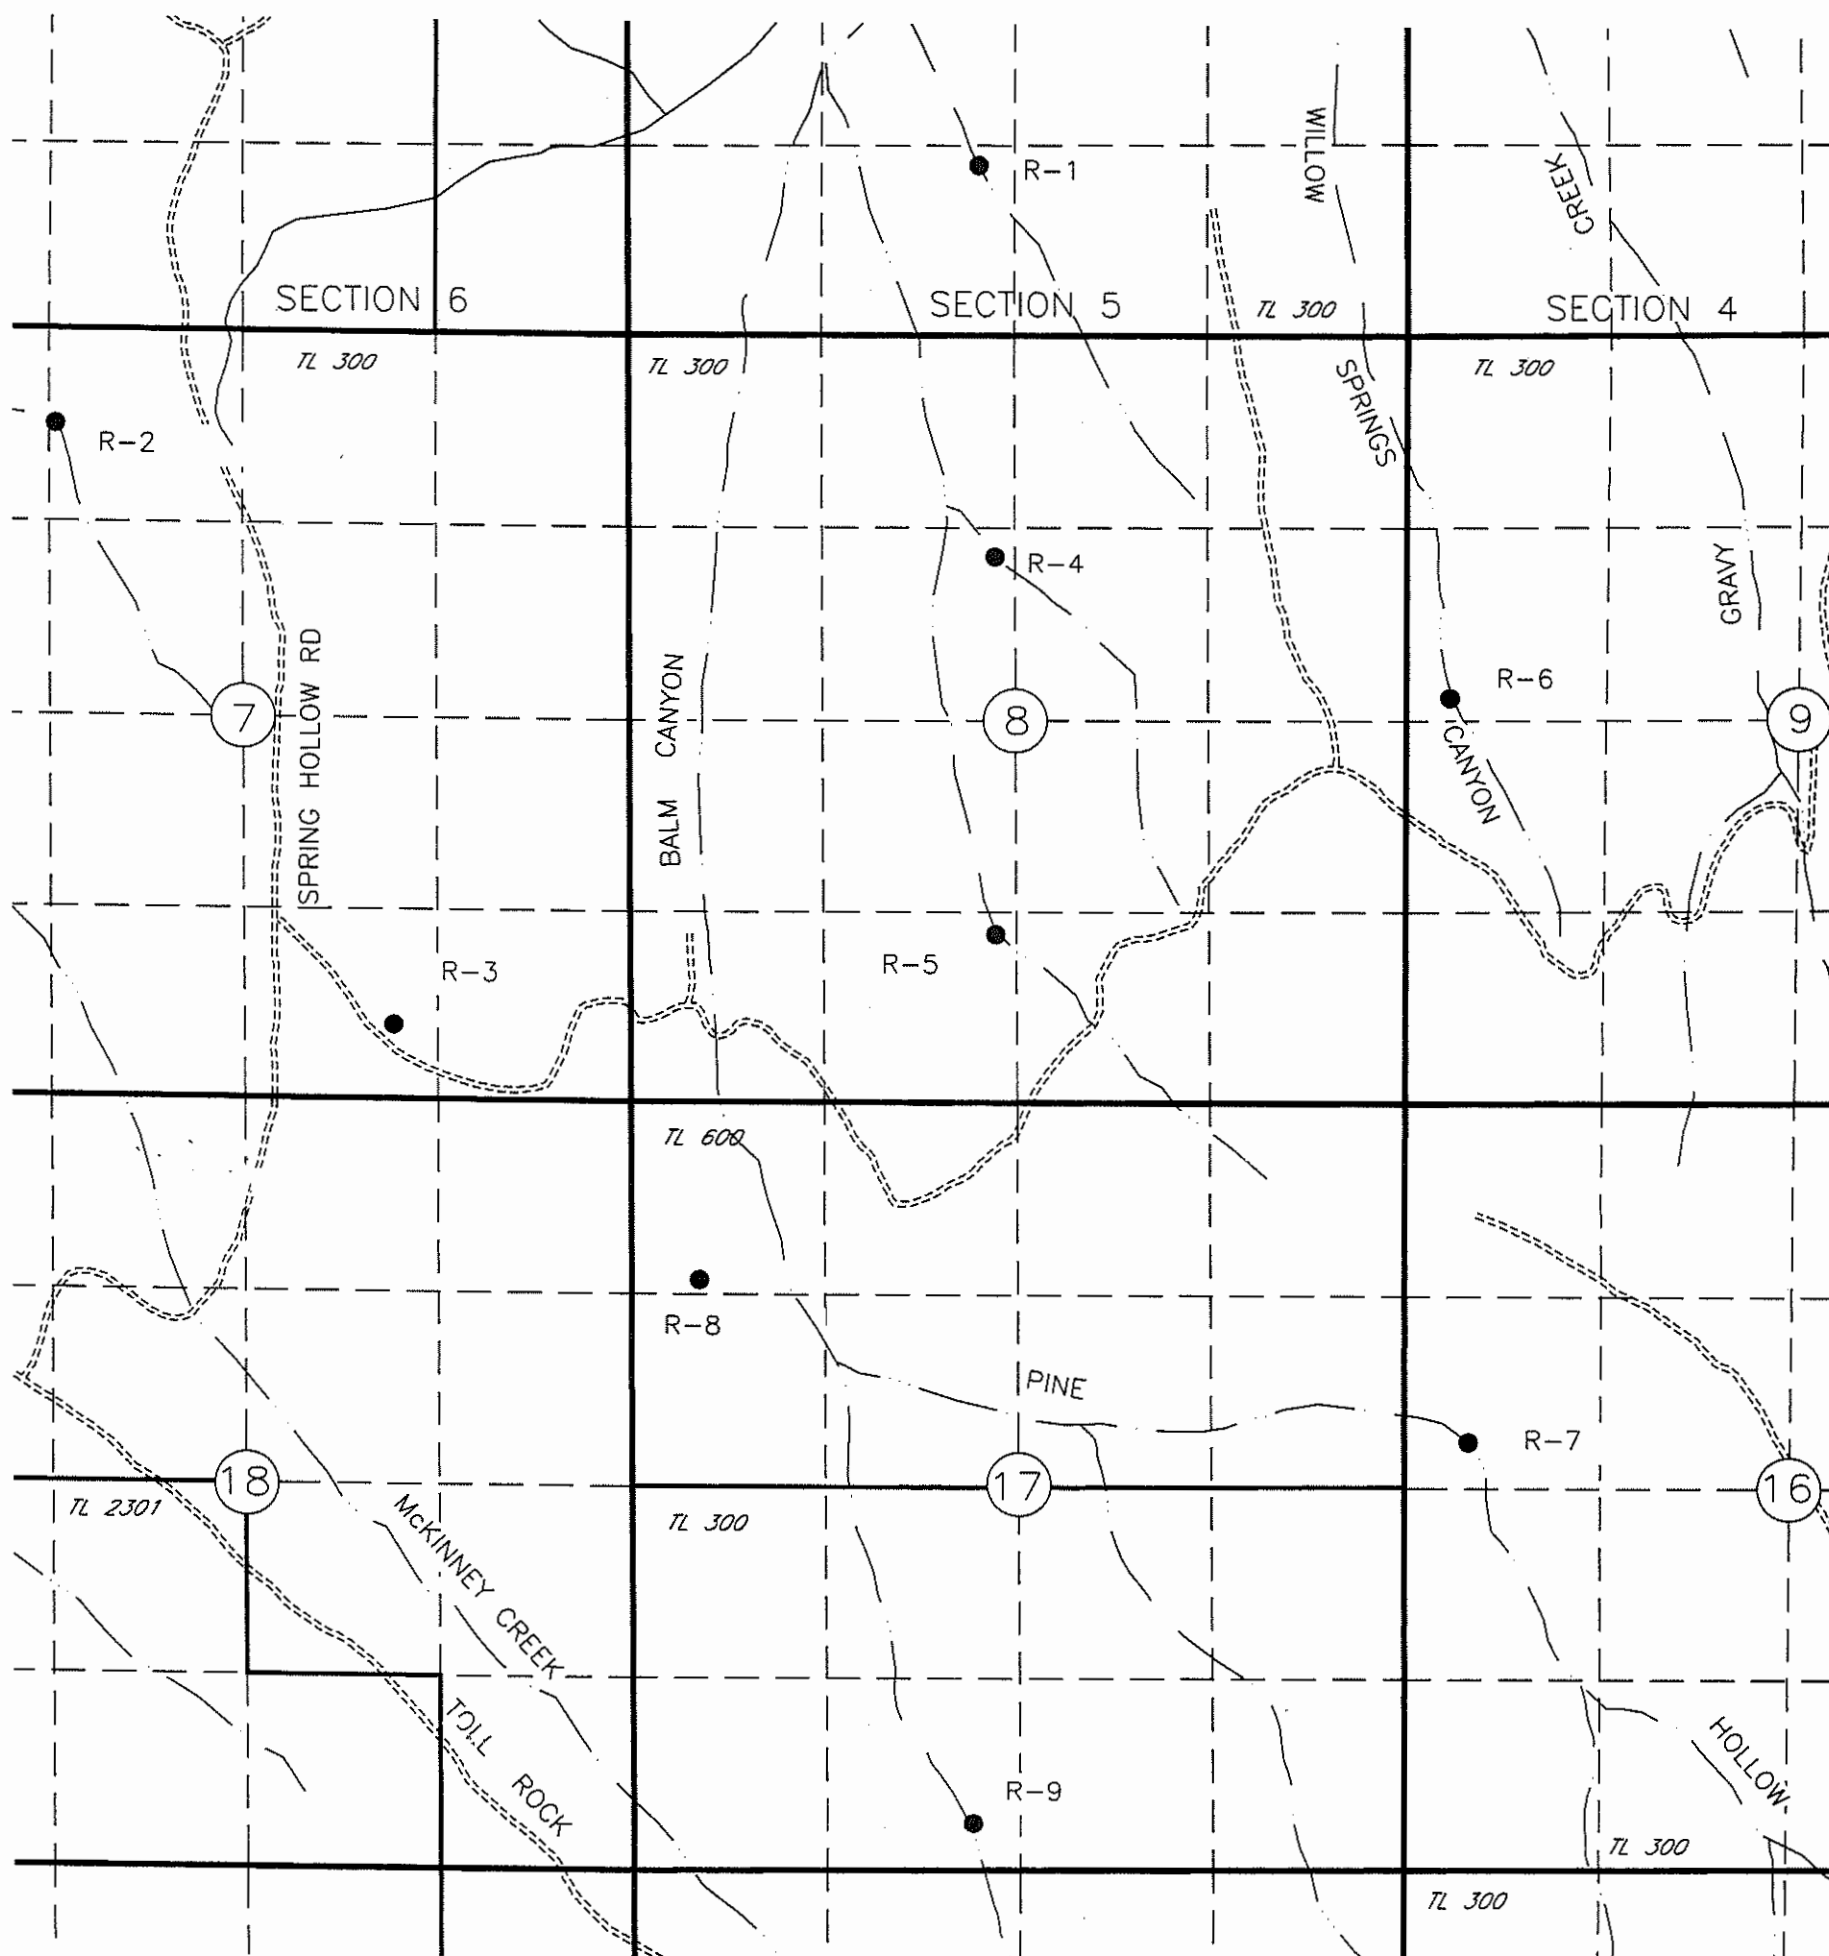


LOCATION OF RESERVOIRS

- R-1 1185' N & 240' W FROM THE S1/4 CORNER OF SEC 5
- R-2 660' S & 1280' W FROM THE N1/4 CORNER OF SEC 7
- R-3 515' N & 1620' W FROM THE SE CORNER OF SEC 7
- R-4 1220' N & 135' W FROM THE CENTER OF SEC 8
- R-5 1155' N & 140' W FROM THE S1/4 CORNER OF SEC 8
- R-6 160' N & 300' E FROM THE W1/4 CORNER OF SEC 9
- R-7 320' N & 440' E FROM THE W1/4 CORNER OF SEC 16
- R-8 1220' S & 460' E FROM THE NW CORNER OF SEC 17
- R-9 320' N & 320' W FROM THE S1/4 CORNER OF SEC 17

LEGEND

- R-7 RESERVOIR LOCATION AND DESIGNATION
- BOTTOM OF DRAINAGE BASIN, DRAINAGE IS TO THE NORTH

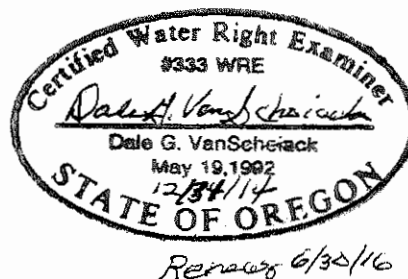

NOTE:
THE PURPOSE OF THIS MAP IS TO IDENTIFY THE APPROXIMATE LOCATION OF THE WATER RIGHT. IT IS NOT INTENDED TO PROVIDE INFORMATION RELATIVE TO THE LOCATION OF PROPERTY OWNERSHIP BOUNDARY LINES.

JUB
J-U-B ENGINEERS, INC.