


**T.5S. R.1E. W.M.**  
CLACKAMAS COUNTY

TAX LOT:  
5 1E 27 00700  
5 1E 27 00701  
5 1E 27 00702

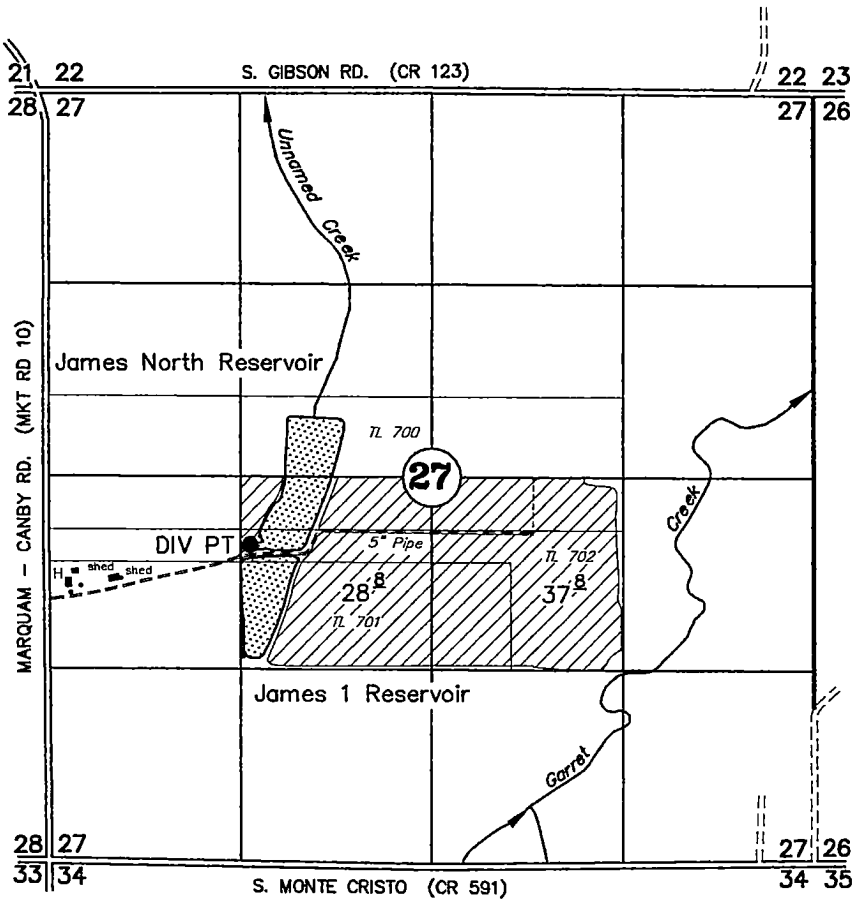

DIV PT: 2170' N & 1385' E OF SW COR SECTION 27  
ELECTRICAL METER: 2125' N & 1375' E OF SW COR SECTION 27


**CLAIM OF BENEFICIAL USE .**  
UNDER

Application No. S-84510 Permit No. S-53927

**RON VANDECOEVERING**

AUGUST 2, 2011  
SCALE: 1" = 1320'

NOTE: This map is for the purpose of identifying the location of water rights and has no intent to dimension or locate property ownership lines.

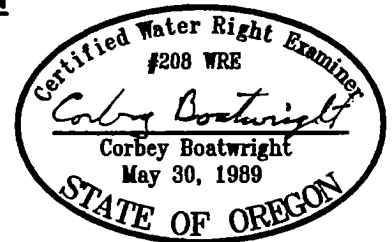

Renewal Date: December 31, 2011