T.5S. R.1E. W.M.

CLACKAMAS COUNTY

TAX LOT:
5 1E 27 00700
5 1E 27 00701
5 1E 27 00702

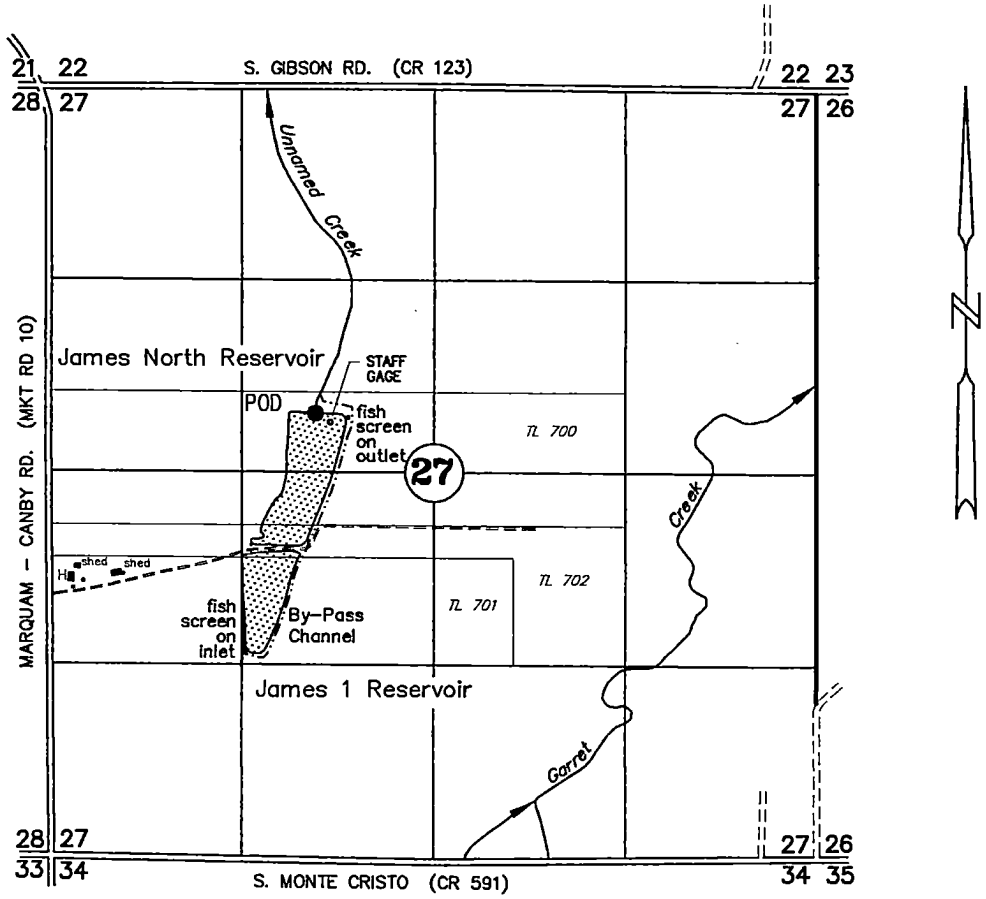

POD: 3042' N & 1830' E OF SW COR SECTION 27
STAFF GAGE: 2980' N & 1932' E OF SW COR SECTION 27

CLAIM OF BENEFICIAL USE

UNDER

Application No. R-85185 / R-84508 Permit No. R-13970 / R-13608

RON VANDECOEVERING

AUGUST 2, 2011

SCALE: 1" = 1320'

Certified Water Right Examiner
#208 WRE
Corbey Boatwright
May 30, 1989
STATE OF OREGON

NOTE: This map is for the purpose of identifying the location of water rights and has no intent to dimension or locate property ownership lines.

Renewal Date: December 31, 2011