


T.5S. R.1E. W.M.  
CLACKAMAS COUNTY

TAX LOT:  
5 1E 27 00700  
5 1E 27 00701  
5 1E 27 00702

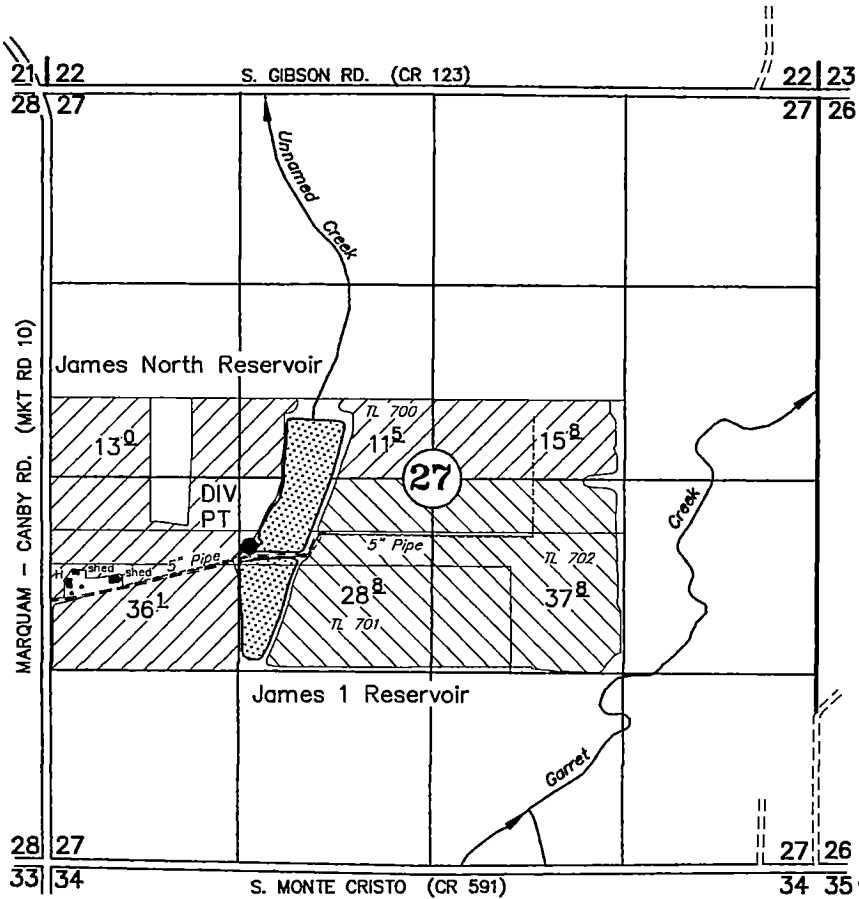

DIV PT: 2170' N & 1385' E, OF SW COR SECTION 27  
ELECTRICAL METER: 2125' N & 1375' E OF SW COR SECTION 27

**CLAIM OF BENEFICIAL USE  
UNDER**

Application No. S-85186

Permit No. S-54069


 PRIMARY

 SUPPLEMENTAL

**RON VANDECOEVERING**

AUGUST 2, 2011  
rev: JULY 18, 2018

SCALE: 1" = 1320'

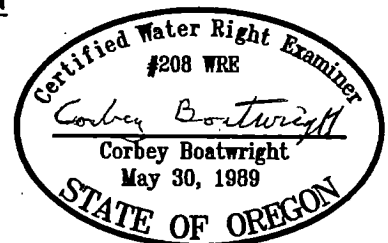

NOTE: This map is for the purpose of identifying the location of water rights and has no intent to dimension or locate property ownership lines.

Expires: 12/31/19