
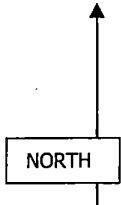


FINAL PROOF SURVEY MAP

IN THE NAME OF FESSLER FAMILY LLC

T 5 S, R 1 W, W.M. Section 28

Application G-16836, Permit G-16541

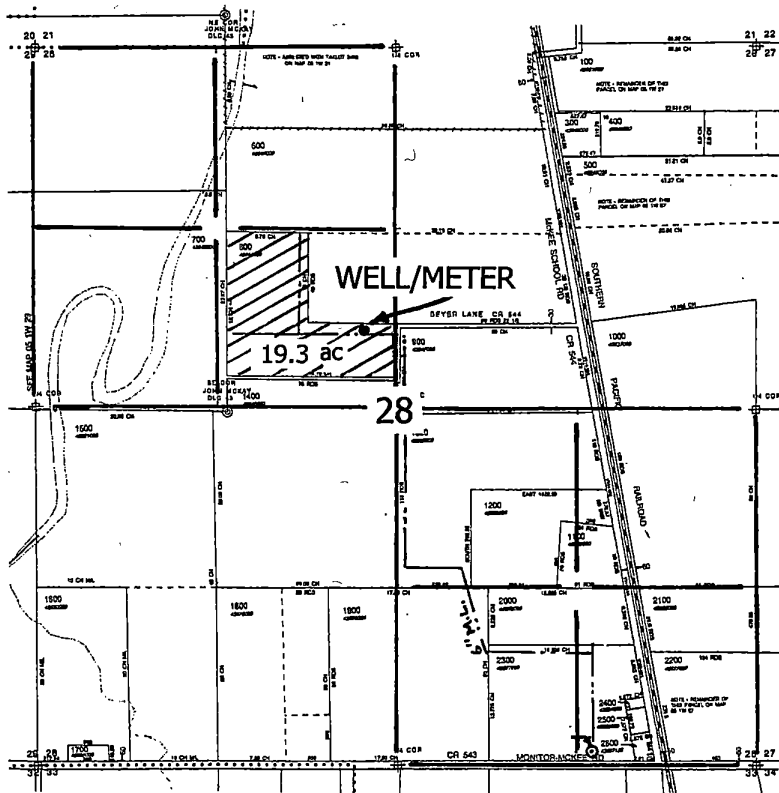

RECEIVED


MAR 30 2015

WATER RESOURCES DEPT
SALEM, OREGON

Well: 570' N & 220' W of the center 1/4 corner section 28

- Section Line _____
- 1/4 1/4 line _____
- Tax Lot Line _____
- Pipe Line - - - - -

Scale 1" = 1320'

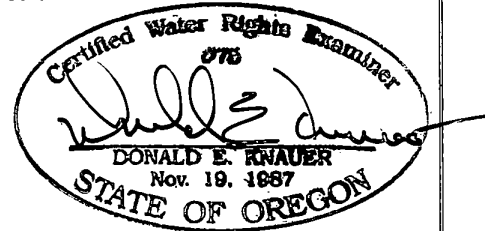

This map is not intended to provide legal dimensions or locations of property ownership lines .

RENEWAL DATE: 6/30/2015