


DIVERSION: N 570', W 630'
1/4 CORNER
SECTION 35 T.15S. R.7W.

SEC. 35 T.15S. R.7W. W.M.

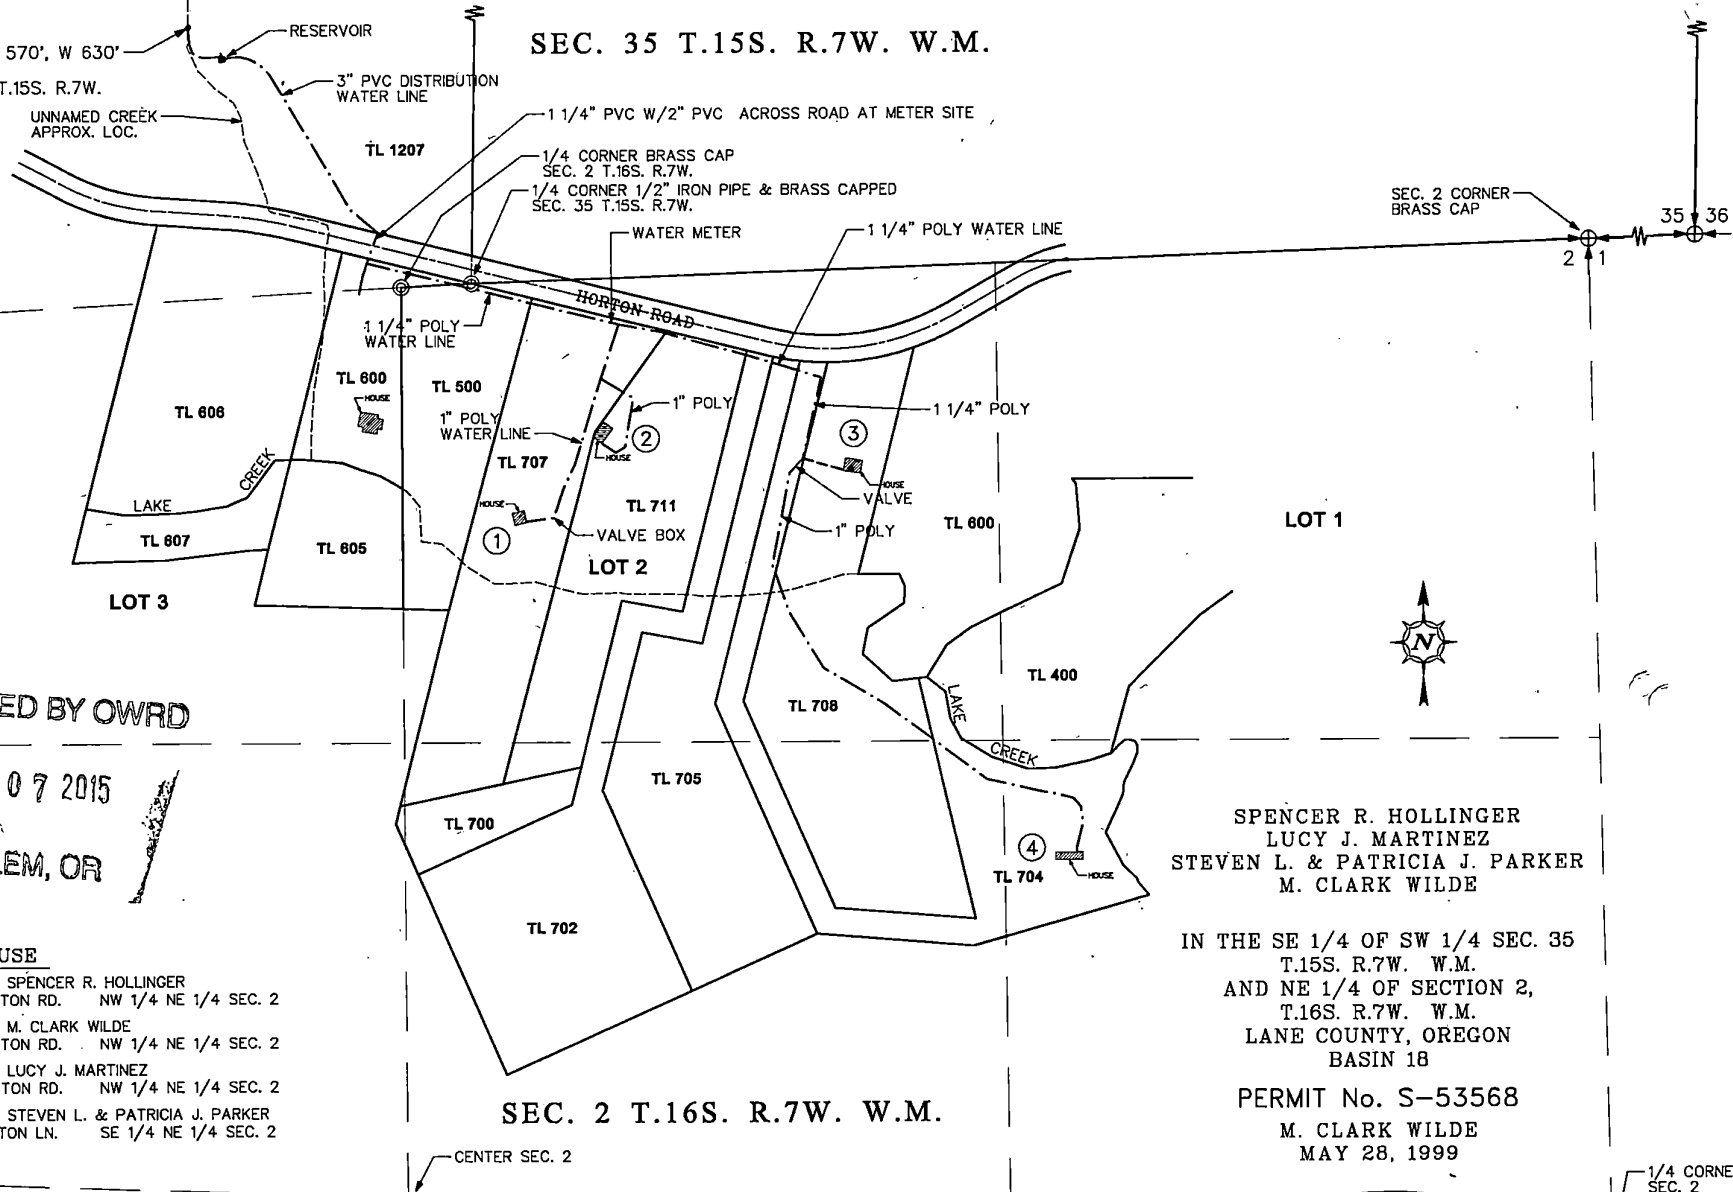

RECEIVED BY OWRD

MAY 07 2015
SALEM, OR

POINT OF USE

- ① T.L. 707 SPENCER R. HOLLINGER
94296 HORTON RD. NW 1/4 NE 1/4 SEC. 2
- ② T.L. 711 M. CLARK WILDE
94290 HORTON RD. NW 1/4 NE 1/4 SEC. 2
- ③ T.L. 708 LUCY J. MARTINEZ
94270 HORTON RD. NW 1/4 NE 1/4 SEC. 2
- ④ T.L. 704 STEVEN L. & PATRICIA J. PARKER
21455 HORTON LN. SE 1/4 NE 1/4 SEC. 2

SEC. 2 T.16S. R.7W. W.M.

SPENCER R. HOLLINGER
LUCY J. MARTINEZ
STEVEN L. & PATRICIA J. PARKER
M. CLARK WILDE

IN THE SE 1/4 OF SW 1/4 SEC. 35
T.15S. R.7W. W.M.
AND NE 1/4 OF SECTION 2,
T.16S. R.7W. W.M.
LANE COUNTY, OREGON
BASIN 18

PERMIT No. S-53568
M. CLARK WILDE
MAY 28, 1999

FINAL PROOF MAP

1" = 400'

NOTE:
THIS MAP IDENTIFIES THE LOCATION OF THE
WATER RIGHT ONLY, AND IS NOT INTENDED TO PROVIDE
DIMENSIONS OR LOCATE PROPERTY OWNERSHIP LINES.

BY:

MIKE McALLISTER ENGINEERING

11301 E. MAPLETON ROAD
MAPLETON, OREGON 97453
PH: 541-268-4326
FAX: 541-268-4326

