



Section 7, T6S, R20E, W.M., Wheeler County, Oregon
 Application R-87806, Permit R-14973
 CLAIM OF BENEFICIAL USE MAP
 Stanley Ranch LLC

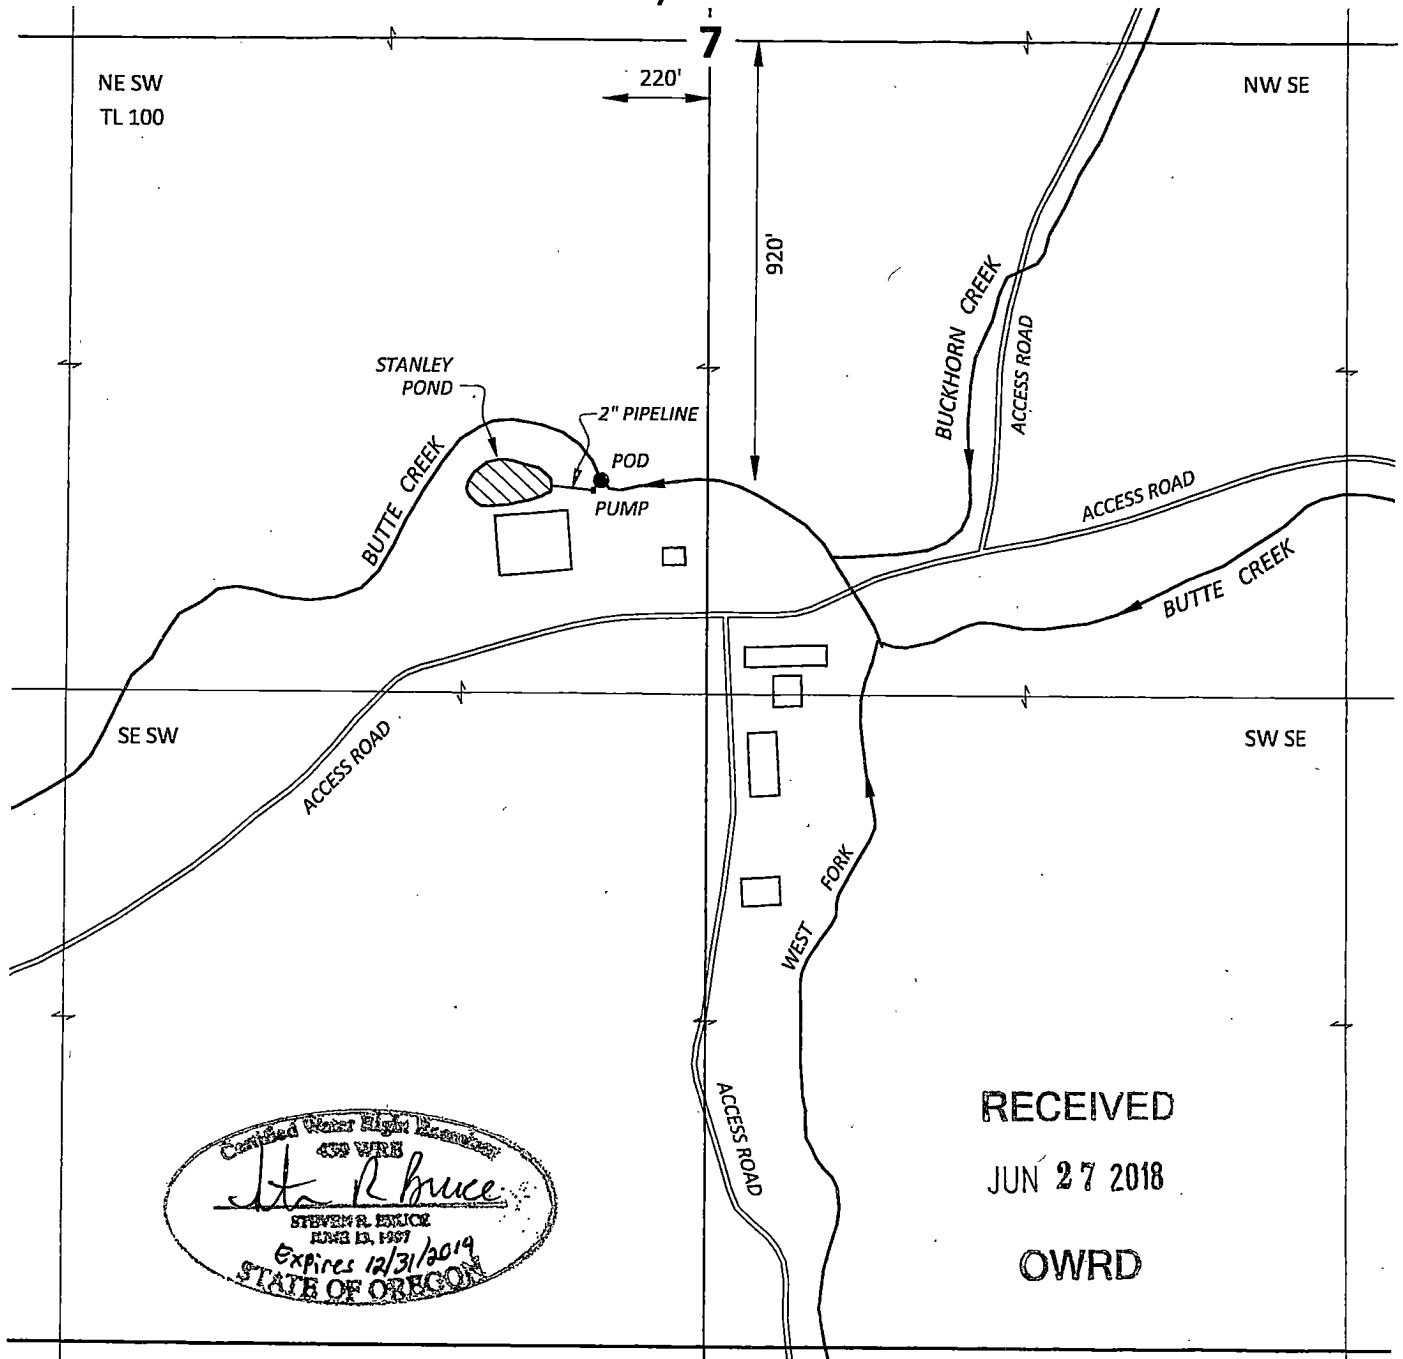

EXPLANATION

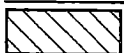

PLACE OF USE
 VOLUME = 1.8 ACRE-FEET / SURFACE AREA = 0.3 ACRE
 PRIORITY: May 2, 2012
 POINT OF DIVERSION

SKOOKUM
 WATER ASSOCIATES INC
 P.O. BOX 80174
 PORTLAND, OR 97280
 (503) 319-8926



SCALE
 200 0 200 400
 1 INCH = 400 FEET

Site inspection conducted
 June 6, 2018
 June 7, 2018

This map is not intended to provide
 legal dimensions or locations of
 property ownership lines

Figure 1