


1715

DEMARIS IRRIGATION DITCH

SCALE 2 INCHES = 1 MILE

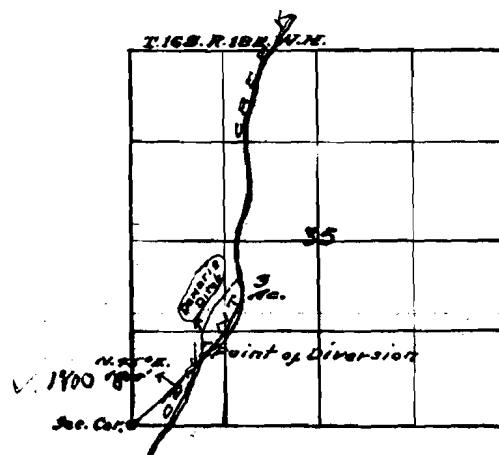

1. Robert
that the
tual su
correct
ing app
and oth
written
division

OFFICE OF STATE ENGINEER

RECEIVED

APR 18 1912

DAVID L. ORR

Application No. 2191

Permit No. 1134

I, Robert Demaris of Prineville Oregon do hereby certify that this map was made from notes taken during an actual survey made by me in March 1912 and that it correctly represents the works described in the accompanying application, together with the location of streams and other ditches in the immediate vicinity and has written thereon the area in each smallest legal subdivision it is proposed to irrigate

Robt Demaris