

FINAL PROOF MAP



TO ADD & CHANGE POINTS OF APPROPRIATION &
PLACE OF USE FOR PERMITS G-16975 & G-17098
JUNIPER BASIN RANCH, LLC


TOWNSHIP 25 SOUTH, RANGE 31 EAST, SECTIONS 18 & 19, W.M.
TAX LOTS: 3700 & 3800

RECEIVED BY CWRD

MAY 30 2015

SALEM, OR

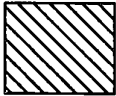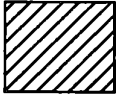
-  240.0 ACRES PRIMARY IRRIGATION FROM WELLS 1 & 2, G-16491 (T-11461), AS SHOWN
-  78.1 ACRES PRIMARY IRRIGATION FROM WELLS 1 & 2, G-17098, AS SHOWN

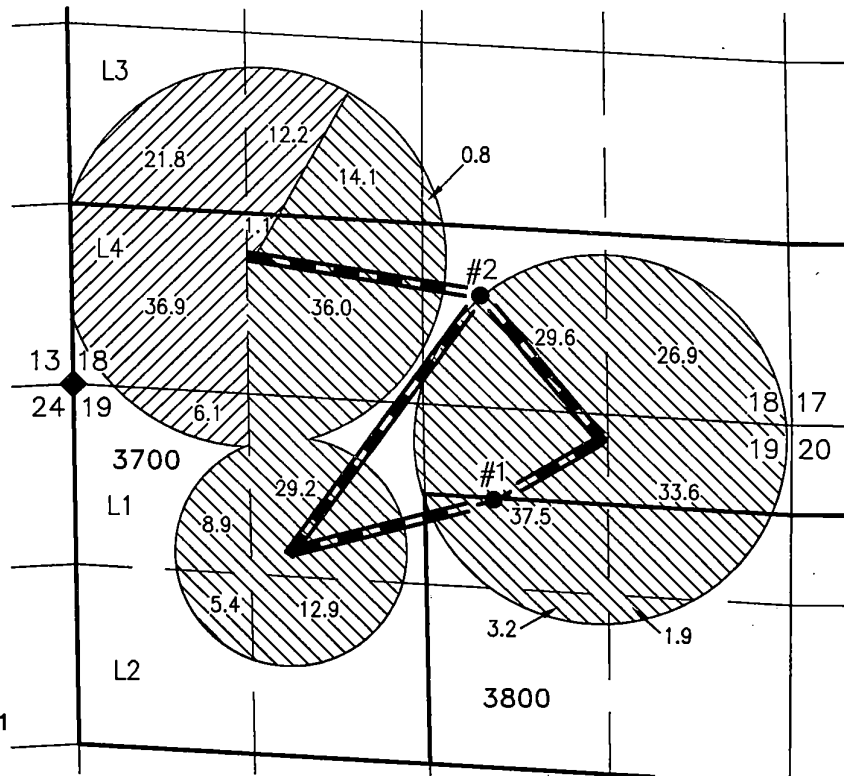

— BURIED 6 OR 8 INCH STEEL PIPE —

◆ SECTION CORNER MONUMENT

- #1 (HARN 51409)
LOCATED IN THE NW 1/4 NE 1/4 SECTION 19, T25S R31E, W.M. AND 830 FEET SOUTH AND 3033 FEET EAST FROM THE NW CORNER OF SAID SECTION.
FLOW METER IS 6.0' EAST OF WELL.
- #2 (HARN 51783)
LOCATED IN THE SW 1/4 SE 1/4 SECTION 18, T25S, T31E, W.M. AND 660 FEET NORTH & 2935 FEET EAST FROM THE SW CORNER OF SAID SECTION.
FLOW METER IS 6.0' EAST OF WELL

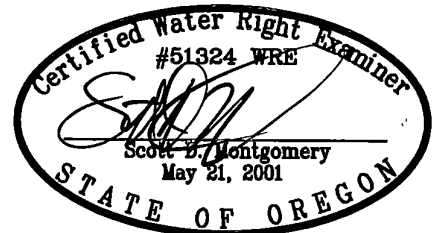

RENEWAL DATE: 12/31/2016

THIS MAP IS FOR THE PURPOSE OF LOCATING A WATER RIGHT ONLY AND HAS NO INTENT TO PROVIDE LEGAL DIMENSIONS OR THE LOCATION OF PROPERTY LINES.

PREPARED FOR:

JON WARREN
P.O. BOX 491942
REDDING, CA 96049-1942

PREPARED BY:



ALL POINTS ENGINEERING AND SURVEYING, INC.
P.O. BOX 767 TERREBONNE, OR 97760
(541) 548-5833 www.APEandS.com